

CARD MUST BE TYPED

State of Kansas  
**NOTICE OF INTENTION TO DRILL**  
(see rules on reverse side)

15-167-22670-00-00

CARD MUST BE SIGNED

Starting Date: 9 24 85  
month day year

API Number 15-

167-22,670

OPERATOR: License # 6033  
Name: Murfin Drilling Co.

NW NW NW Sec 11 Twp 12 S, Rge 15  
(location)  East  West

Address: 250 N. Water, Suite 300

4950 Ft North from Southeast Corner of Section

City/State/Zip: Wichita, Ks. 67202

4950 Ft West from Southeast Corner of Section

Contact Person: David Doyel

(Note: Locate well on Section Plat on reverse side)

Phone: 316-267-3241

Nearest lease or unit boundary line 330' feet.

CONTRACTOR: License # 6033

County: Russell

Name: Murfin Drilling Co.

Lease Name: Pratt-Foster Well# 1

City/State: Wichita, Ks. 67202

Domestic well within 330 feet:  yes  no

Well Drilled For: Well Class: Type Equipment:

Oil  Swd  Infield  Mud Rotary  
 Gas  Inj  Pool Ext.  Air Rotary  
 OWWO  Expl  Wildcat  Cable

Municipal well within one mile:  yes  no

If OWWO: old well info as follows:

Depth to Bottom of fresh water 180 feet

Lowest usable water formation Dakota 500 feet

Depth to Bottom of usable water

Surface pipe by Alternate: 1  2

Surface pipe to be set 7 1/2" approx 250' approx feet

Conductor pipe if any required

Ground surface elevation 1647 feet MSL

This Authorization Expires 3-24-86

Approved By 9-24-85 [Signature]

I certify that we will comply with K.S.A. 55-101, et seq., plus eventually plugging hole to K.C.C. specifications.

Date 9/24/85 Signature of Operator or Agent [Signature]


Title Geologist

Must be filed with the K.C.C. five (5) days prior to commencing well  
This card void if drilling not started within six (6) months of date received by K.C.C.

RECEIVED  
STATE CORPORATION COMMISSION  
STATE 9-24-1985  
SEP 24 1985

A Regular Section of Land  
1 Mile = 5,280 Ft.

CONSERVATION DIVISION  
Wichita, Kansas

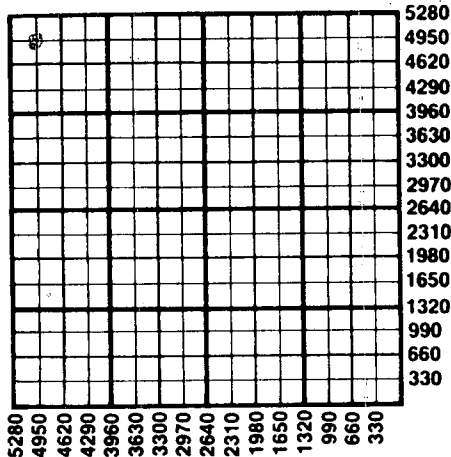

Important procedures to follow:

1. Notify District office before setting surface casing.
2. Set surface casing by circulating cement to the top.
3. File completion forms ACO-1 with K.C.C. within 90 days of well completion, following instructions on ACO-1, side 1, and including copies of wireline logs.
4. Notify District office 48 hours prior to old well workover or re-entry.
5. Prior to plugging, prepare a plugging plan, then obtain agreement from the appropriate district office for an approved plugging plan.
6. Submit plugging report (CP-4) to K.C.C. after plugging is completed.
7. Obtain an approved injection docket number before disposing of salt water.
8. Notify K.C.C. within 10 days when injection commences or terminates.
9. If an alternate 2 completion, cement in the production pipe from below any usable water to surface within 120 days of spud date.

State Corporation Commission of Kansas  
Conservation Division  
200 Colorado Derby Building  
Wichita, Kansas 67202  
(316) 263-3238