

NOTICE OF INTENTION TO DRILL

(see rules on reverse side)

Starting Date 9 25 85 month day year

API Number 15- 163-22,771-0000

OPERATOR: License # 5560 Name DAVIS BROS OIL PRODUCERS INC Address One Williams Center Suite 2000 City/State/Zip Tulsa, OK 74172 Contact Person Charles Arnold Phone 913-434-7116

E/2 NW SE Sec 17 Twp 10 S Rg 18 West 1,940 Ft. from South Line of Section 1,620 Ft. from East Line of Section

(Note: Locate well on Section Plat on reverse side)

CONTRACTOR: License # 6033 Name Murfin Drilling Company City/State Wichita, KS 67202

Nearest lease or unit boundary line 660 feet

County Rooks

Lease Name ORDWAY Well # C-8

Ground surface elevation 2,157 feet MSL

Well Drilled For: Well Class: Type Equipment: X Oil SWD X Infield X Mud Rotary Gas Inj Pool Ext Air Rotary OWWO Expl Wildcat Cable

Domestic well within 330 feet: yes X no

Municipal well within one mile: yes X no

Surface pipe by Alternate: 1 2 X

Depth to bottom of fresh water 100'

Depth to bottom of usable water 900'

Surface pipe planned to be set 200' of 8-5/8"

Projected Total Depth 3,800 feet

Formation Lansing-KC

If OWWO: old well info as follows: Operator Well Name Comp Date Old Total Depth

I certify that well will comply with K.S.A. 55-101, et seq., plus eventually plugging hole to KCC specifications.

cementing will be done immediately upon setting production casing.

Date 9-20-85 Signature of Operator or Agent Mary Hill Title Prod. Assistant

For KCC Use:

Conductor Pipe Required feet; Minimum Surface Pipe Required feet per Alt 1 2


This Authorization Expires 3-23-86 Approved By 9-23-85

Must be filed with the K.C.C. five (5) days prior to commencing well
This card void if drilling not started within six (6) months of date received by K.C.C.

Important procedures to follow:

1. Notify District office before setting surface casing.
 2. Set surface casing by circulating cement to the top.
 3. File completion forms ACO-1 with K.C.C. within 90 days of well completion, following instructions on ACO-1, side 1, and including copies of wireline logs.
 4. Notify District office 48 hours prior to old well workover or re-entry.
 5. Prior to filing Intent, prepare a proposed plugging plan in case well is D & A, then obtain approval of plan when calling district office prior to setting surface pipe.
 6. Submit plugging report (CP-4) to K. C. C. after plugging is completed.
 7. Obtain an approved injection docket number before disposing of salt water.
 8. Notify K.C.C. within 10 days when injection commences or terminates.
- an alternate 2 completion, cement in the production pipe from below any usable water to surface within 120 days of spud date.

A Regular Section of Land
1 Mile = 5,280 Ft.

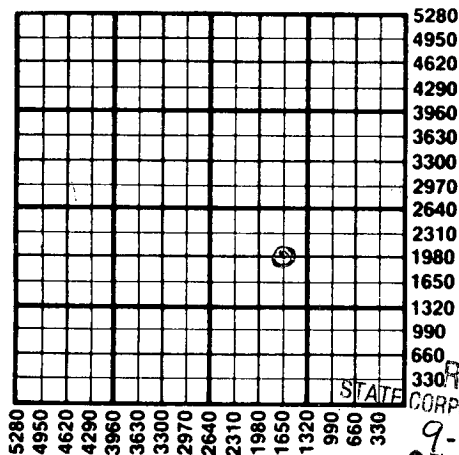

RECEIVED
CORPORATION COMMISSION
9-23-85
SEP 23 1985
CONSERVATION DIVISION
Wichita, Kansas

State Corporation Commission of Kansas
Conservation Division
200 Colorado Derby Building
Wichita, Kansas 67202
(316) 263-3238