

CARD MUST BE TYPED

State of Kansas  
**NOTICE OF INTENTION TO DRILL**

CARD MUST BE SIGNED

(see rules on reverse side)

Starting Date: June 19 85  
month day year

API Number 15- 163-22,695-0000

OPERATOR: License # 5537

SE SE SW Sec 21 Twp 10 S, Rge 18  
(location)  East  West

Name Kenny Brown Enterprises

Address Drawer 340

City/State/Zip Plainville, Kansas 67663

Contact Person Kenneth O. Brown

Phone 913-434-7236

330 Ft North from Southeast Corner of Section  
2970 Ft West from Southeast Corner of Section  
(Note: Locate well on Section Plat on reverse side)

CONTRACTOR: License # 9087

Name R & C Drilling Company

City/State Box 296 Hays, Kansas 67604

Nearest lease or unit boundary line 330 feet

County Rooks

Lease Name Ordway Well# C-1

Domestic well within 330 feet:  yes  no

Municipal well within one mile:  yes  no

Well Drilled For: Well Class: Type Equipment:

Oil  Swd  Infield  Mud Rotary

Gas  Inj  Pool Ext.  Air Rotary

OWWO  Expl  Wildcat  Cable

Depth to Bottom of fresh water 160 feet

Lowest usable water formation Dakota

Depth to Bottom of usable water 860 feet

Surface pipe by Alternate: 1  2

Surface pipe to be set 200 feet

Conductor pipe if any required 2071 feet

Ground surface elevation feet MSL

This Authorization Expires 11-29-85

Approved By 5-29-85

If OWWO: old well info as follows:

Operator

Well Name

Comp Date Old Total Depth

Projected Total Depth 3700 feet

Projected Formation at TD Arbuckle

Expected Producing Formations LKC

I certify that we will comply with K.S.A. 55-101, et seq., plus eventually plugging hole to K.C.C. specifications.

Date 5-24-85 Signature of Operator or Agent Kenneth O. Brown Title Owner & Operator

Form C-1 4/84


MHC/UDHE 5-29-85

RECEIVED  
STATE CORPORATION COMMISSION  
5-29-85  
MAY 29 1985

Must be filed with the K.C.C. five (5) days prior to commencing well  
This card void if drilling not started within six (6) months of date received by K.C.C.

CONSERVATION DIVISION  
Wichita, Kansas

A Regular Section of Land  
1 Mile = 5,280 Ft.

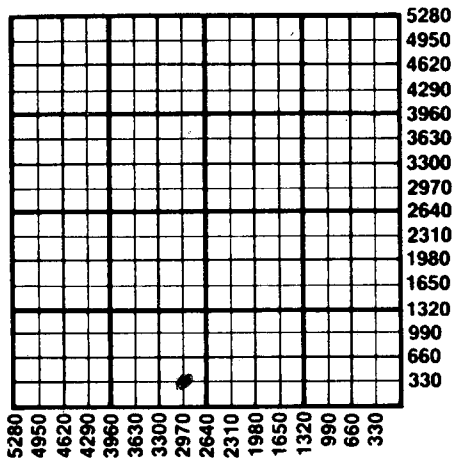

**Important procedures to follow:**

1. Notify District office before setting surface casing.
2. Set surface casing by circulating cement to the top.
3. File completion forms ACO-1 with K.C.C. within 90 days of well completion, following instructions on ACO-1, side 1, and including copies of wireline logs.
4. Notify District office 48 hours prior to old well workover or re-entry.
5. Prior to plugging, prepare a plugging plan, then obtain agreement from the appropriate district office for an approved plugging plan.
6. Submit plugging report (CP-4) to K.C.C. after plugging is completed.
7. Obtain an approved injection docket number before disposing of salt water.
8. Notify K.C.C. within 10 days when injection commences or terminates.
9. If an alternate 2 completion, cement in the production pipe from below any usable water to surface within 120 days of spud date.

State Corporation Commission of Kansas  
Conservation Division  
200 Colorado Derby Building  
Wichita, Kansas 67202  
(316) 263-3238