


15-163-19016-0000

STATE OF KANSAS  
STATE CORPORATION COMMISSION

Give All Information Completely  
Make Required Affidavit  
Mail or Deliver Report to:  
Conservation Division  
State Corporation Commission  
211 No. Broadway  
Wichita, Kansas

WELL PLUGGING RECORD

NORTH

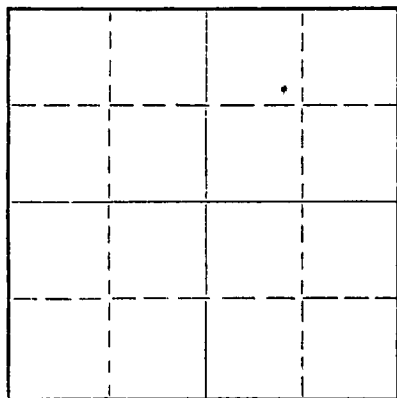

Locate well correctly on above  
Section Plat

Rooks County. Sec. 36 Twp. 10S Rge. 17 (E) W (W)  
Location as "NE/CNW/SW" or footage from lines SE NW NE  
Lease Owner White Eagle Oil Company  
Lease Name Brungardt Well No. 1  
Office Address First National Bldg., Tulsa 3, Oklahoma  
Character of Well (completed as Oil, Gas or Dry Hole) Dry Hole  
Date well completed July 28, 19 57  
Application for plugging filed July 28, 19 57  
Application for plugging approved July 28, 19 57  
Plugging commenced July 28, 19 57  
Plugging completed July 28, 19 57  
Reason for abandonment of well or producing formation Dry Hole

If a producing well is abandoned, date of last production \_\_\_\_\_ 19\_\_\_\_  
Was permission obtained from the Conservation Division or its agents before plugging was commenced? Yes

Name of Conservation Agent who supervised plugging of this well Eldon Petty  
Producing formation \_\_\_\_\_ Depth to top \_\_\_\_\_ Bottom \_\_\_\_\_ Total Depth of Well 3540 Feet  
Show depth and thickness of all water, oil and gas formations.

OIL, GAS OR WATER RECORDS

CASING RECORD

FORMATION	CONTENT	FROM	TO	SIZE	PUT IN	PULLED OUT
		0	258	8 5/8"	258	none

Describe in detail the manner in which the well was plugged, indicating where the mud fluid was placed and the method or methods used in introducing it into the hole. If cement or other plugs were used, state the character of same and depth placed, from \_\_\_\_\_ feet to \_\_\_\_\_ feet for each plug set.

From 3540' to 550' - heavy rotary mud and plug  
550' to 473' - 25 sacks posmix, 2% cc  
473' to 240' - heavy rotary mud and plug  
240' to 194' - 15 sacks posmix, 2% cc  
194' to 40' - heavy rotary mud and plug  
40' to 6' - 10 sacks posmix, 2% cc  
6' to surface - cellar

(If additional description is necessary, use BACK of this sheet)

Name of Plugging Contractor Peel Brothers, Inc.  
Address P.O. Box 88, Hoisington, Kansas

STATE OF KANSAS, COUNTY OF BARTON, ss.  
Peel Brothers, Inc. (employee of owner) or (~~conservation agent~~) of the above-described well, being first duly sworn on oath, says: That I have knowledge of the facts, statements, and matters herein contained and the log of the above-described well as filed and that the same are true and correct. So help me God. PEEL BROTHERS, INC.

(Signature) by: Al H. Smith  
P.O. Box 88, Hoisington, Kansas  
(Address)

SUBSCRIBED AND SWORN TO before me this 30th day of July, 19 57

My commission expires April 27, 1960

Ruth Brank  
Notary Public.

PLUGGING  
FILE SEC 36 T. 10 R. 17W  
BOOK PAGE 32 LINE 33

8-2-57  
AUG 2 1957  
CONSERVATION DIVISION  
Wichita, Kansas

DRILLERS' LOG

Company: White Eagle Oil Company  
Farm Name: Brungardt Well No. 1  
Total Depth: 3540'  
Comm: 7/19/57 Comp: 7/28/57  
Contractor: Peel Brothers, Inc.  
Casing: 8 5/8" @ 258' cem.

SE NW NE  
Sec. 36, Twp. 10S, Rge. 17W,  
County: Rooks,  
Kansas  
Elevation:  
Production: Dry

Figures below indicate bottoms of formations:

Surface soils	0 -	258
Sand, shale, iron pyrite		595
Pyrite and sand		615
Sand		775
Shale and red rock		950
Red bed and shale		1120
Anhydrite		1150
Shale		1260
Shale and red bed		1685
Shale and lime		2800
Lime		2911
Lime and shale		3055
Lime		3110
Shale and lime		3187
Lime		3381
Lime and congl and chert		3445
Lime and shale		3490
Conglomerate		3527
Lime		3540
Total Depth		3540

This is to certify that the above information is to the best of our knowledge, true and correct.

PEEL BROTHERS, INC.

BY: Al H. Smith

SUBSCRIBED AND SWORN to before me this 30th day of July, 1957

My commission expires: April 27, 1960

Ruth Brant  
Notary Public

PLUGGING  
FILE SEC 36 T 10 R 17W  
BOOK PAGE 32 LINE 33

CONFIRMATION DIVISION  
Wichita, Kansas  
AUG 2 1957