


STATE OF KANSAS
STATE CORPORATION COMMISSION

WELL PLUGGING RECORD

Give All Information Completely
Make Required Affidavit
Mail or Deliver Report to:
Conservation Division
State Corporation Commission
800 Bittling Building
Wichita, Kansas

Rooks County. Sec. 8 Twp. 10S Rge. 18 (E) W (W)

Location as "NE/CNWSWK" or footage from lines C SW NE SE
Lease Owner The Atlantic Refining Company
Lease Name Elizabeth C. Ordway Well No. 2
Office Address P. O. Box 17, Great Bend, Kansas
Character of Well (completed as Oil, Gas or Dry Hole) Dry hole.
Date well completed 2-4 1954
Application for plugging filed 2-4 1954
Application for plugging approved 2-4 1954
Plugging commenced 2-4 1954
Plugging completed 2-4 1954
Reason for abandonment of well or producing formation Dry

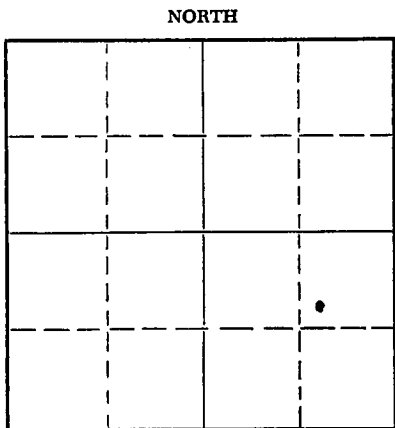

Locate well correctly on above
Section Plat

If a producing well is abandoned, date of last production _____ 19____
Was permission obtained from the Conservation Division or its agents before plugging was commenced? Yes.

Name of Conservation Agent who supervised plugging of this well Eldon Petty, Box 326, Hays, Kansas
Producing formation _____ Depth to top _____ Bottom _____ Total Depth of Well 3810 Feet
Show depth and thickness of all water, oil and gas formations.

OIL, GAS OR WATER RECORDS

CASING RECORD

FORMATION	CONTENT	FROM	TO	SIZE	PUT IN	PULLED OUT
				10-3/4"	1266'	0

Describe in detail the manner in which the well was plugged, indicating where the mud fluid was placed and the method or methods used in introducing it into the hole. If cement or other plugs were used, state the character of same and depth placed, from _____ feet to _____ feet for each plug set.

Plugged hole as per state orders.
Run drill pipe open end and spotted 100 sacks Pozmix cement at 3241'. Pulled drill pipe and pushed HOUCCO plug to 300' and spotted 20 sacks cement. Filled hole within 25' of top. Pushed HOUCCO plug down and cemented to surface with 10 sacks cement. Job completed 6:00 P. M., 2-4-54. Released rotary 7:00 P. M., 2-4-54. P&A.

Name of Plugging Contractor Nye & Snell Drilling Company (If additional description is necessary, use BACK of this sheet)
Address Hays, Kansas

STATE OF KANSAS, COUNTY OF BARTON, ss.
Stanton K. Myers (employee of owner) or (owner or operator) of the above-described well, being first duly sworn on oath, says: That I have knowledge of the facts, statements, and matters herein contained and the log of the above-described well as filed and that the same are true and correct. So help me God.

(Signature) Stanton K. Myers
P. O. Box 17, Great Bend, Kansas
(Address)

SUBSCRIBED AND SWORN TO before me this 15 day of February, 1954

My commission expires 7-18-55 Bradshaw Notary Public.

PLUGGING
FILE SEC 8 10 1680
BOOK PAGE 12 LINE 26

2-16-54

THE ATLANTIC REFINING COMPANY
830 Kennedy Building
Tulsa, Oklahoma

WELL LOG

Ordway No. 2

Location: C SW NE SE of 8-108-18W, Rooks County, Kansas.

Lease Number: KS-13,685

Elevations: 2192' RKB, 2189' DP, 2186' GL.

Spudded: 7:00 P. M. January 22, 1954

Reached Total Depth: February 4, 1954

Contractor: Nye & Snell Drilling Company

Casing Record: Ran 41 joints (1258') of 10-3/4" O.D. 32.75# H-40 ST&C casing and cemented at 1266' RKB with 400 sacks of Pozmix followed by 150 sacks of cement plus 200# of calcium chloride.

FORMATION RECORD:

Cellar	0'- 5'
Surface & clay	5'- 45'
Sand & gravel	45'- 90'
Shale	90'- 280'
Shale, blue	280'- 380'
Shale & shells	380'- 670'
Sand streaks with shale	670'- 850'
Sandy shale & iron	850'-1030'
Shale & iron	1030'-1040'
Shale & sand	1040'-1060'
Sand	1060'-1170'
Shale	1170'-1300'
R. B. & shale	1300'-1590'
Anhydrite	1590'-1625'
R. B. & shale	1625'-1775'
Shale & shells	1775'-2030'
Shale & salt	2030'-2050'
Shale & lime streaks	2050'-2255'
Shale & lime	2255'-2505'
Lime & shale	2505'-3410'
Lime	3410'-3690'
Conglomerate	3690'-3780'
Arbuckle	3780'-3810'

3810' T.D.

Completion: Dry hole - P. & A.

PLUGGING
 FRI SEC 8 T 10 R 18W
 BOOK PAGE 12 LINE 26