


STATE OF KANSAS
STATE CORPORATION COMMISSION

Give All Information Completely
Make Required Affidavit
Mail or Deliver Report to
Conservation Division
State Corporation Commission
245 North Water
Wichita, KS 67202

FORM CP-4

WELL PLUGGING RECORD

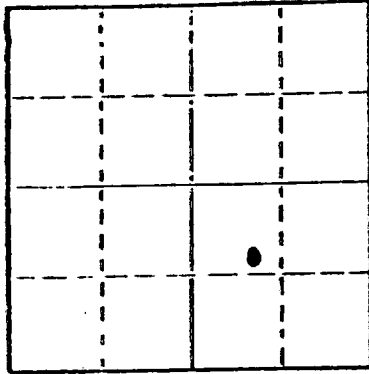

Locate well correctly on above
Section Plat

Rooks _____ County. Sec. 8 Twp. 10SRgs. (E) 18 (W)
Location as "NE/CN/WSW" or footage from lines S/2 SE NW NE 1250' ENL & 1650' FEL
Lease Owner TENNECO OIL CO.
Lease Name Williams Field Waterflood Well No. 3-7 ^{ET} _{KCC}
Office Address 139 Ciudad Bldg 3000 United Founders Tower Okla. City
Character of Well (completed as Oil, Gas or Dry Hole) Salt Water Disposalok 73112
Date well completed _____ 19 67
Application for plugging filed _____ 3/18 19 76
Application for plugging approved _____ 5/27 19 76
Plugging commenced _____ 8/3 19 76
Plugging completed _____ 8/6 19 76
Reason for abandonment of well or producing formation Casing Leaks

If a producing well is abandoned, date of last production _____ 19
Was permission obtained from the Conservation Division or its agents before plugging was commenced? yes

Name of Conservation Agent who supervised plugging of this well Leo Massey
Producing formation Granite Wash (Disposal) Depth to top 3999 Bottom 4173 Total Depth of Well 4173 Feet
Show depth and thickness of all water, oil and gas formations.

OIL, GAS OR WATER RECORDS				CASING RECORD		
FORMATION	CONTENT	FROM	TO	SIZE	FEET IN	PULLED OUT
Granite Wash(Disposal)	Dom. Lime & Sand	3,999	4,173	8-5/8"	271'	NONE
				5-1/2"	3,999'	NONE

Describe in detail the manner in which the well was plugged, indicating where the mud fluid was placed and the method or methods used in introducing it into the hole. If cement or other plugs were used, state the character of same and depth placed, from _____ feet to _____ feet for each plug set.

Pulled 130 jts. Duo-lined 2-7/8" tbg & Baker ~~Log~~ -SEt packer. Ran 129 jts (3,992')
2-7/8" steel tbg - pumped 27 sxs gel, 5 sxs hulls and 50 sxs cement into the Granite
Wash formation - laid down 10 jts tbg, pumped 110 sxs cement into the Lansing-Kansas
City thru the casing leaks laid down 98 jts run wireline and checked top of cement
at - 3000 pumped 8 sxs gel 5 sxs hull and 100 sxs cement into Dakota casing leak
and from 650' to surface - pulled 21 jts tbg - welded steel plate over 8-5/8"
surface casing.

(If additional description is necessary, use BACK of this sheet)

Name of Plugging Contractor Halliburton
Address Hayes, Kansas

STATE OF Oklahoma COUNTY OF Oklahoma, ss.
W. L. Shaver (employee of owner) or (owner or operator) of the above-described

well, being first duly sworn on oath, says: That I have knowledge of the facts, statements, and matters herein contained and the log of the above-described well as filed and that the same are true and correct. So help me God.

(Signature) W L Shaver
Oklahoma City, Oklahoma
(Address)

Subscribed and sworn to before me this 20th day of September, 1976

My commission expires November 7, 1979
Juan M. Harris Notary Public.

9-24-76