


STATE OF KANSAS
STATE CORPORATION COMMISSION

Give All Information Completely
Make Required Affidavit
Mail or Deliver Report to:
Conservation Division
State Corporation Commission
211 No. Broadway
Wichita, Kansas

WELL PLUGGING RECORD

NORTH

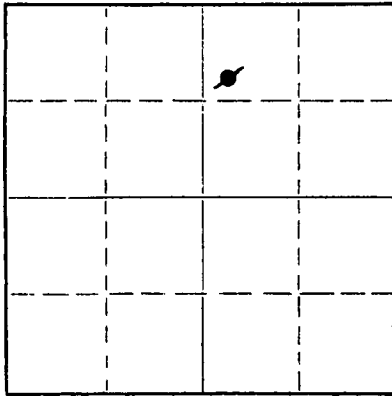

Locate well correctly on above
Section Plat

Rocks _____ County, Sec. 16 Twp. 10 Rge. (E) 18 (W)
Location as "NE/CNW/SW" or footage from lines SW NW NE
Lease Owner C-G Drilling Company
Lease Name Ordway Well No. "A" # 1
Office Address Box 637 Plainville, Kansas
Character of Well (completed as Oil, Gas or Dry Hole) Abandoned Oil Well
Date well completed June 19 1953
Application for plugging filed yes 19
Application for plugging approved yes 19
Plugging commenced 9-27-61 19
Plugging completed 9-30-61 19
Reason for abandonment of well or producing formation No longer commercial

If a producing well is abandoned, date of last production September 13 1961
Was permission obtained from the Conservation Division or its agents before plugging was commenced? yes

Name of Conservation Agent who supervised plugging of this well Eldon Petty
Producing formation Lansing - K. C. Depth to top 3408' Bottom 3615' Total Depth of Well 3155' Feet
Show depth and thickness of all water, oil and gas formations. 3768

OIL, GAS OR WATER RECORDS

CASING RECORD

FORMATION	CONTENT	FROM	TO	SIZE	PUT IN	PULLED OUT
				5 1/2"	3546.95'	1,602'
				8-5/8"	182.33'	None

Describe in detail the manner in which the well was plugged, indicating where the mud fluid was placed and the method or methods used in introducing it into the hole. If cement or other plugs were used, state the character of same and depth placed, from _____ feet to _____ feet for each plug set.

Plugging commenced 9-27-61. Plugging completed 9-30-61.
Measured in to total depth: 3455'.
Plugged off bottom: Sanded back to 3435' and dumped 4 sacks cement.
Worked and shot 5 1/2" casing, freed at 1602'. Built rack and slide. Pulled and layed down casing.
Plugged well: Through 5 1/2": circulated 18 sacks mud at 565' and pumped 20 sacks cement; pumped 20 sacks cement at 250'. Capped the well with 10 sacks cement.

10-13-61

(If additional description is necessary, use BACK of this sheet)

Name of Plugging Contractor Forbes Casing Pulling, Inc.
Address P. O. Box 221 Great Bend, Kansas

STATE OF Kansas, COUNTY OF Barton, ss.
J. O. Forbes (employee of owner) or (owner or operator) of the above-described well, being first duly sworn on oath, says: That I have knowledge of the facts, statements, and matters herein contained and the log of the above-described well as filed and that the same are true and correct. So help me God.

(Signature) J. O. Forbes
Great Bend, Kansas
(Address)

SUBSCRIBED AND SWORN TO before me this 2nd day of October, 1961

My commission expires December 8th, 1963

Kayann Jenkins
Notary Public.



W E L L L O G

OPERATOR C-G Drilling Co. SEC. 16-10S-18W
 WELL NAME Ordway "A" LOC. SW NW NE
 TOTAL DEPTH 3768' COUNTY Rooks
 Drilling June 7, 1953 Drilling June 19, 1953 STATE Kansas
 COMP. COMP.
 RIG NO. 2 ELEVATION 2187' R.B.
 CASING: Left in hole 182.66' 8-5/8" OD Surface Casing. PRODUCTION: Plugged & Abandoned
 And 1944.95' 5-1/2" OD Casing. September 30, 1961

All measurements taken from the top of rotary bushing.

FROM	TO	FORMATION	DEVIATION FROM VERTICAL	REMARKS:
0	575	Shale, Shells & Sand		
575	1050	Shale & Shells		
1050	1270	Sand		
1270	1355	Shale & Shells		
1355	1425	Shale		
1425	1568	Red Bed		
1568	1606	Anhydrite		
1606	2030	Shale		
2030	2220	Shale & Shells		
2220	2420	Lime & Shale		
2420	2515	Shale & Lime	0° - 2500	
2515	3435	Lime & Shale	0° - 2750	DST 3330'-3340'
3435	3550	Lime	0° - 3000	DST 3372'-3391'
3550	3585	Lime & Shale	0° - 3250	DST 3432'-3451'
3585	3625	Lime	0° - 3500	DST 3460'-3475'
3625	3710	Lime & Shale		DST 3557'-3585'
3710	3735	Cherty, Lime & Shale		
3735	3768	Lime & Shale		

RECEIVED
 STATE OF KANSAS
 OCT 19 1961
 CONSERVATION DIVISION
 Wichita, Kansas

STATE OF KANSAS)
 COUNTY OF SEDGWICK) SS.

The undersigned hereby certifies that to the best of his knowledge and belief, the above facts are true and correct.

C-G DRILLING CO.
 By G. F. Galloway

G. F. Galloway
 THIS 3rd day of October, 1961.

Vicky Jacobs
 Vicky Jacobs - Notary Public

