

15-163-00845-0000


STATE OF KANSAS  
STATE CORPORATION COMMISSION

WELL PLUGGING RECORD

Give All Information Completely  
Make Required Affidavit  
Mail or Deliver Report to:  
Conservation Division  
State Corporation Commission  
800 Bitting Building  
Wichita, Kansas

Rooks County. Sec. 17 Twp. 10 Rge. 18 (E) W (W)  
Location as "NE/CNW/SW" or footage from lines NE SW  
Lease Owner Nadel and Gussman  
Lease Name Smith Well No. 1  
Office Address 1714 First National Building  
Character of Well (completed as Oil, Gas or Dry Hole) Dry  
Date well completed 10-29-55  
Application for plugging filed 10-29-55  
Application for plugging approved 10-29-55  
Plugging commenced 10-29-55  
Plugging completed 10-29-55  
Reason for abandonment of well or producing formation Dry

NORTH

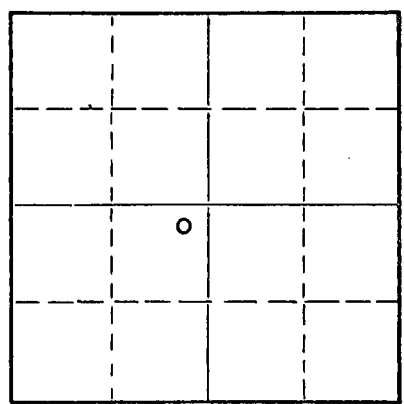

Locate well correctly on above  
Section Plat

If a producing well is abandoned, date of last production \_\_\_\_\_ 19\_\_\_\_  
Was permission obtained from the Conservation Division or its agents before plugging was commenced? Yes

Name of Conservation Agent who supervised plugging of this well Eldon Petty  
Producing formation \_\_\_\_\_ Depth to top \_\_\_\_\_ Bottom \_\_\_\_\_ Total Depth of Well 3800 Feet  
Show depth and thickness of all water, oil and gas formations.

OIL, GAS OR WATER RECORDS

CASING RECORD

FORMATION	CONTENT	FROM	TO	SIZE	PUT IN	PULLED OUT
				8-5/8"	175'	0

Describe in detail the manner in which the well was plugged, indicating where the mud fluid was placed and the method or methods used in introducing it into the hole. If cement or other plugs were used, state the character of same and depth placed, from \_\_\_\_\_ feet to \_\_\_\_\_ feet for each plug set.

Filled hole from TD to 160' of top with heavy mud  
Set plug with 15 sax cement  
Filled hole to 40' of top - set plug with 10 sax cement

(If additional description is necessary, use BACK of this sheet)  
Name of Plugging Contractor Reserve Drilling Company, Inc.  
Address 703 Union National Building, Wichita 2, Kansas

STATE OF KANSAS, COUNTY OF SEDGWICK, ss.  
L. C. Hay (employee of owner) of the above-described well, being first duly sworn on oath, says: That I have knowledge of the facts, statements, and matters herein contained and the log of the above-described well as filed and that the same are true and correct. So help me God.  
(Signature) L. C. Hay  
Wichita, Kansas  
(Address)

SUBSCRIBED AND SWORN TO before me this 1st day of November 1955  
Nola Babb Notary Public.

My commission expires 11-3-56

Rec'd  
Oct 31, 1955  
KCC

PLUGGING  
FILE NO. 17-10-18W  
BOOK PAGE 12 LINE 17

WELL LOG

Nadel and Gussman

SMITH No. 1

NE SW 17-10-18W

Rooks County, Kansas

Casing: 8-5/8" 175' w/125 sax

Comm: 10-20-55

Comp: 10-29-55

<u>Formations</u>	<u>Depth</u>
Shale	170
Shale and shells	800
Sand and shale	1050
Sand	1240
Shale and red bed	1578
Anhydrite	1625
Shale and shells	1940
Shale and lime	2150
Shale and lime shells	2335
Shale and lime	2565
Shale	2765
Shale and shells	2840
Shale and lime	3290
Lime	3325
Lime and shale	3415
Lime	3645
Lime and shale	3679
Cherty Conglomerate	3732
Conglomerate	3785
Arbuckle	3800

Geological Tops

Topeka	3180
Heebner Shale	3368
Toronto	3385
Lans-Kansas City	3410
Base Kansas City	3616
Conglomerate	3656
Simpson Dolomite	3736
Arbuckle	3767

STATE OF KANSAS )  
 COUNTY OF SEDGWICK ) SS:

L. C. Hay, of lawful age, states that the above formations and tops are correct as shown by the daily drilling log of the Smith No. 1 Well in the NE SW 17-10-18W, Rooks County, Kansas.

L. C. Hay  
 L. C. Hay

Subscribed and sworn to before me this 1st day of November, 1955.

Nola Babb  
 Nola Babb, Notary Public

My commission expires Nov. 3, 1956

