


15-163-20360-0000

STATE OF KANSAS
STATE CORPORATION COMMISSION

Form CP-4

Give All Information Completely
Make Required Affidavit
Mail or Deliver Report to:
Conservation Division
State Corporation Commission
212 No. Market
Wichita, Kansas 67202

WELL PLUGGING RECORD

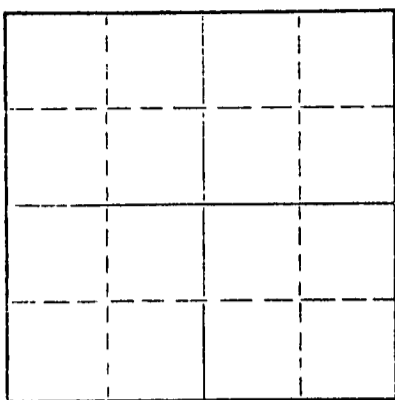

Locate well correctly on above
Section Plat

Rooks County, Sec. 17 Twp. 10 Rge. 18 (E) (W)X
Location as "NE/CNW/SE/SW" or footage from lines SE/SE/NW

Lease Owner Hummon Oil, Inc.

Lease Name Rempe Well No. 1

Office Address 6409 East 14th St. Wichita, Kansas 67206

Character of Well (completed as Oil, Gas or Dry Hole)

Date well completed 19

Application for plugging filed 19

Application for plugging approved 19

Plugging commenced 3-8-72 19

Plugging completed 3-16-72 19

Reason for abandonment of well or producing formation Depleted

If a producing well is abandoned, date of last production 19

Was permission obtained from the Conservation Division or its agents before plugging was commenced? Yes

Name of Conservation Agent who supervised plugging of this well Leo Massey

Producing formation Depth to top Bottom Total Depth of Well 3773 Feet

Show depth and thickness of all water, oil and gas formations.

OIL, GAS OR WATER RECORDS

CASING RECORD

FORMATION	CONTENT	FROM	TO	SIZE	PUT IN	PULLED OUT
				8 5/8	209	None
				4 1/2	3779	1734.21'

Describe in detail the manner in which the well was plugged, indicating where the mud fluid was placed and the method or methods used in introducing it into the hole. If cement or other plugs were used, state the character of same and depth placed, from feet to feet for each plug set.

Pushed a plug to 3550' and dumped 25 ft. sand and 4 sacks cement. Shot casing at 3250, 3140, 3000, 2800, 2600, 2400, 2200, 2000, 1900, 1800 and 1730 ft. Pulled a total of 54 jts. of 4 1/2" casing. Squeezed well with 5 sacks hulls, 25 sacks gel and 120 sacks 50/50 nozmix with 6% added gel.

STATE RECEIVED
3-21-72
MAR 21 1972
CONSERVATION DIVISION
Wichita, Kansas


Name of Plugging Contractor Rockhold Engineering, Inc.
Address Box 698 Gt. Bend, Kansas 67530

STATE OF Kansas, COUNTY OF Barton, ss. James W. Rockhold

(employee of owner) or (owner or operator) of the above-described well, being first duly sworn on oath, says: That I have knowledge of the facts, statements, and matters herein contained and the log of the above described well as filed and that the same are true and correct. So help me God.

(Signature) James W. Rockhold James W. Rockhold
Box 698 Great Bend, Kansas 67530

(Address) March 20th day of March, 1972

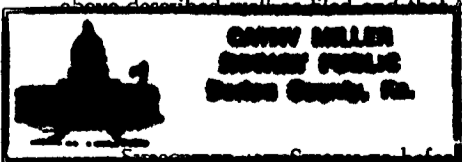

Cathy Miller
Cathy Miller Notary Public.

My commission expires September 30, 1975