

15-163-00037-2000

STATE OF KANSAS
STATE CORPORATION COMMISSION

WELL PLUGGING RECORD

Give All Information Completely
Make Required Affidavit
Mail or Deliver Report to:
Conservation Division
State Corporation Commission
800 Bitting Building
Wichita, Kansas


OR

FORMATION PLUGGING RECORD

Strike out upper line
when reporting plug-
ging off formations.

Rooks County Sec. 20 Twp. 10 Rge. (E) 18 (W)
Location as "NE 1/4 NW 1/4 SW 1/4" or footage from lines NE NW NE
Lease Owner Donald T. Ingling
Lease Name Crowley Well No. 1
Office Address 708 4th Nat'l Bank Bldg., Wichita 2, Kansas
Character of Well (completed as Oil, Gas or Dry Hole) Dry Hole
Date well completed 4/23 1946
Application for plugging filed 4/23 1946
Application for plugging approved 4/23 1946
Plugging commenced 4/23 1946
Plugging completed 4/23 1946
Reason for abandonment of well or producing formation

NORTH

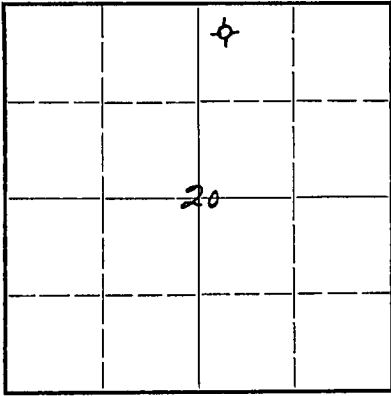

Locate well correctly on above
Section Plat

If a producing well is abandoned, date of last production 19
Was permission obtained from the Conservation Division or its agents before plugging was com-
menced? Yes

Name of Conservation Agent who supervised plugging of this well Mr. W. H. Kerr, Great Bend, Kansas
Producing formation Depth to top Bottom Total Depth of Well 3835 Feet
Show depth and thickness of all water, oil and gas formations.

OIL, GAS OR WATER RECORDS

CASING RECORD

Formation	Content	From	To	Size	Put In	Pulled Out
				13-3/8	120	None

Describe in detail the manner in which the well was plugged, indicating where the mud fluid was placed and the method or methods used in introducing it into the hold. If cement or other plugs were used, state the character of same and depth placed, from feet to feet for each plug set.

Jotted pits - circulated heavy mud 30 minutes - layed down 2000' drill pipe - filled hole with heavy mud - layed down balance drill pipe - filled hole with heavy mud to 115' - placed wood plug at 115' - run 15 sacks cement on this plug - filled hole with heavy mud to 25' - placed second wood plug at 25' - run 10 sacks cement on this plug.

20 10 18W
51 39
4-26-46

(If additional description is necessary, use BACK of this sheet)

Correspondence regarding this well should be addressed to Donald T. Ingling
Address 708 4th Nat'l Bank Bldg., Wichita 2, Kansas

STATE OF _____, COUNTY OF _____, ss.

_____ (employee of owner) or (owner or operator) of the above-described well, being first duly sworn on oath, says: That I have knowledge of the facts, statements, and matters herein contained and the log of the above-described well as filed and that the same are true and correct. So help me God.

(Signature) *Donald T. Ingling*

708 4th Nat'l Bank Bldg., Wichita 2, Kas.
(Address)

SUBSCRIBED AND SWORN to before me this 26th day of April, 1946

Leah W. Landrus
Notary Public.

My commission expires April 10, 1948

15-163-00037-000

WELL LOG ORDWAY NO. 1

Ingling & Huber - Lease Owners

Sec. 20, Twp. 10, Range 18W

Donald T. Ingling - Contractor

Location: NW NW NE

Total Depth: 3835'

County: Rooks (Kansas)

Commenced: March 16, 1946

Elevation: 2168'

Completed: April 23, 1946

Casing: 120' of 13-3/8"

Production: Dry Hole

Figures below indicate bottom of formation:

32	Surface Soil & Rock	2955	Lime & Shale
40	Sand	2962	Lime
120	Sand, Shale & Shells	3005	Lime & Shale
675	Shale & Shells	3115	Lime
1225	Sand	3150	Shale & Lime
1300	Red Bed & Shale	3676	Lime
1390	Shale & Shells	3710	Conglomerate
1425	Anhydrite	3773	Cherty Conglomerate
1725	Shale & Shells	3790	Conglomerate
1800	Salt & Shale	3810	Simpson
2085	Shale & Shells	3815	Shale
2125	Lime & Shale	3835	Arb. Lime
2315	Lime	3835	<u>TOTAL DEPTH</u>
2415	Lime & Shale		
2455	Lime		
2620	Lime & Shale		
2895	Lime		

I hereby certify that this is a true and correct log of the above-mentioned well.

DONALD T. INGLING

Donald T. Ingling

STATE OF KANSAS:
: SS.
SEDGWICK COUNTY:

Subscribed and sworn to before me, a Notary Public in said County and State this 26th day of April, 1946.

APR 26 1946

Leah V. Landrus

Notary Public

My Commission expires: 4/10/48

20 10 18W
51 39