


Give All Information Completely
Make Required Affidavit
Mail or Deliver Report to:
Conservation Division
State Corporation Commission
211 No. Broadway
Wichita, Kansas

WELL PLUGGING RECORD

15-163 17412-0000
Form CP-4

NORTH

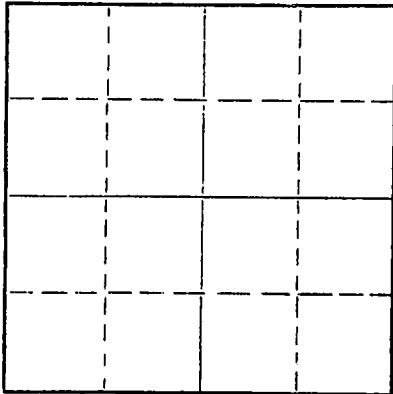

Locate well correctly on above
Section Plat

Rooks County. Sec. 20 Twp. 10S Rge. (E) 18(W)
Location as "NE/CNW&SW&" or footage from lines NW NE NW
Lease Owner Abercrombie Drilling, Inc.
Lease Name ANDRESON Well No. 1
Office Address 801 Union Center, Wichita, Kansas
Character of Well (completed as Oil, Gas or Dry Hole) Dry
Date well completed July 18, 19 64
Application for plugging filed verbally July 17, 19 64
Application for plugging approved verbally July 17, 19 64
Plugging commenced July 17, 19 64
Plugging completed July 18, 19 64
Reason for abandonment of well or producing formation Dry

If a producing well is abandoned, date of last production 19
Was permission obtained from the Conservation Division or its agents before plugging was commenced? Yes

Name of Conservation Agent who supervised plugging of this well Eldon Petty
Producing formation Depth to top Bottom Total Depth of Well 3750 Feet
Show depth and thickness of all water, oil and gas formations.

OIL, GAS OR WATER RECORDS

CASING RECORD

FORMATION	CONTENT	FROM	TO	SIZE	PUT IN	PULLED OUT
				8-5/8"	218'	None

Describe in detail the manner in which the well was plugged, indicating where the mud fluid was placed and the method or methods used in introducing it into the hole. If cement or other plugs were used, state the character of same and depth placed, from feet to feet for each plug set.

Set 1st plug at 540' w/20 sx cement
Set 2nd plug at 220' w/ 20 sx cement & 1/4 sk hulls
Set 3rd plug at 40' w/10 sx cement & 1/2 sk hulls

RECEIVED
STATE CORPORATION COMMISSION
7-23-64
JUL 23 1964

CONSERVATION DIVISION
Wichita, Kansas

(If additional description is necessary, use BACK of this sheet)
Name of Plugging Contractor Abercrombie Drilling, Inc.
Address 801 Union Center, Wichita, Kansas 67202

STATE OF Kansas, COUNTY OF Sedgwick, ss.
B. Lynn Herrington (employee of owner) or (owner or operator) of the above-described well, being first duly sworn on oath, says: That I have knowledge of the facts, statements, and matters herein contained and the log of the above-described well as filed and that the same are true and correct. So help me God.

(Signature) B. Lynn Herrington
801 Union Center, Wichita, Kansas, 67202
(Address)

SUBSCRIBED AND SWORN TO before me this 22nd day of July, 19 64

My commission expires June 16, 1967

Leah Faye Herke

Notary Public.

CONTRACTOR'S WELL LOG

COMPANY: Abercrombie Drilling, Inc.
 CONTRACTOR: Abercrombie Drilling, Inc.
 FARM: ANDRESON #1
 LOCATION: NW NE NW
 Sec. 20-10S-18W
 Rooks County, Kansas
 COMMENCED: July 8, 1964
 COMPLETED: July 18, 1964

0	50	Surface Clay & Sand
50	261	Shale
261	1430	Shale & Sand
1430	1548	Red Shale
1548	1580	Anhydrite
1580	1980	Shale
1980	2225	Shale & Shells
2225	2445	Shale & Lime
2445	2592	Lime & Shale
2592	2802	Shale & Lime
2802	2890	Lime
2890	3166	Shale & Lime
3166	3208	Lime
3208	3312	Lime & Shale
3312	3645	Lime
3645	3716	Lime & Chert
3716	3750	Lime
	3750	Rotary Total Depth

RECEIVED
STATE CORPORATION COMMISSION

JUL 23 1964

CONSERVATION DIVISION
Wichita, Kansas

Set 8-5/8" Surface Casing at 218' w/140 sx common cement, 2% Calcium Chloride

DRY & ABANDONED

ELEVATION: 2158' D. F. & K. B.

ELECTRIC LOG TOPS:


Topeka	3151'	(- 993)
Heebner	3356'	(-1198)
Toronto	3374'	(-1216)
Lansing	3398'	(-1240)
Base Kansas City	3626'	(-1468)
Conglomerate	3651'	(-1493)
Arbuckle	3737'	(-1579)

STATE OF KANSAS)
)SS
 COUNTY OF SEDGWICK)

I, B. Lynn Herrington, do hereby certify that the above and foregoing is a true and correct copy of the log of the ANDRESON #1, NW NE NW, Section 20-10S-18W, Rooks County, Kansas, as reflected by the files of Abercrombie Drilling, Inc.


 B. Lynn Herrington

Subscribed and sworn to before me, a Notary Public, in and for Sedgwick County, Kansas, this 22nd day of July, 1964.

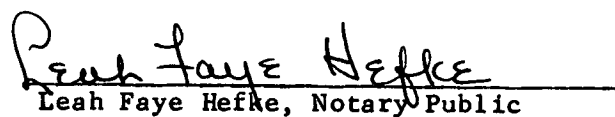
 Leah Faye Hefke, Notary Public

My commission expires June 16, 1967.