


Give All Information Completely  
Make Required Affidavit  
Mail or Deliver Report to:  
Conservation Division  
State Corporation Commission  
211 No. Broadway  
Wichita, Kansas

WELL PLUGGING RECORD

Rooks County. Sec. 20 Twp. 10 Rge. 10 (E) W (W)  
Location as "NE/CNW/SW" or footage from lines SE SW NE  
Lease Owner Davis Bros.  
Lease Name Ordway Well No. 1  
Office Address Tulsa, Okla.  
Character of Well (completed as Oil, Gas or Dry Hole) Oil  
Date well completed January 3, 1958  
T Application for plugging filed Yes 19 58  
LO Application for plugging approved October 7, 1964  
S Plugging commenced Oct. 20 19 64  
Plugging completed Oct. 22 19 64  
Reason for abandonment of well or producing formation Depleted

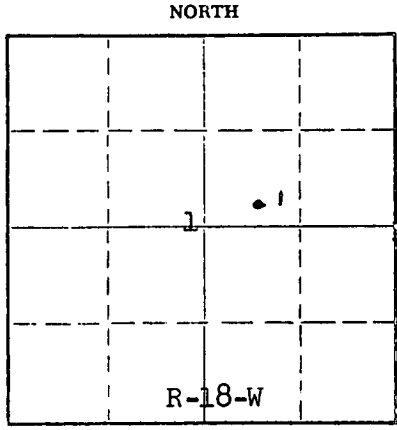

Locate well correctly on above Section Plat

If a producing well is abandoned, date of last production October 15, 1964  
Was permission obtained from the Conservation Division or its agents before plugging was commenced? Yes

Name of Conservation Agent who supervised plugging of this well Petty  
Producing formation Lansing - K.C. Depth to top 3387 Bottom 3610 Total Depth of Well 3741 Feet  
Show depth and thickness of all water, oil and gas formations.

OIL, GAS OR WATER RECORDS

CASING RECORD

FORMATION	CONTENT	FROM	TO	SIZE	PUT IN	PULLED OUT
Lansing - K.C.	Oil	3604	3606	8 5/8"	192'	None
				5 1/2"	3937'	2450'
					7	
					esu	

Describe in detail the manner in which the well was plugged, indicating where the mud fluid was placed and the method or methods used in introducing it into the hole. If cement or other plugs were used, state the character of same and depth placed, from 3741 feet to surface feet for each plug set.

Sanded to 3530' dump 4 sacks of cement on bottom. Pulled pipe to 550' circ. with mud. Pulled pipe to 480' pump 20 sacks of cement. Pulled pipe to 200' pump 20 sacks of cement, Pulled pipe out put 10 sacks of cement on top.  
Well completed.

RECEIVED  
STATE CORPORATION COMMISSION  
12 10 64  
DEC 10 1964

CONSERVATION DIVISION  
Wichita, Kansas

(If additional description is necessary, use BACK of this sheet)

Name of Plugging Contractor Barnes & Sons Pipe Pulling Co.  
Address P.O. Box 313 Russell, Kansas

STATE OF Oklahoma COUNTY OF Tulsa, ss.  
Ralph A. Hockenson (employee of owner) or (owner or operator) of the above-described

well, being first duly sworn on oath, says: That I have knowledge of the facts, statements, and matters herein contained and the log of the above-described well as filed and that the same are true and correct. So help me God.

(Signature) Ralph A. Hockenson  
Ralph A. Hockenson  
510 McFarlin Building - Tulsa, Okla.  
(Address)

SUBSCRIBED AND SWORN TO before me this 9th day of February, 19 64

My commission expires February 28, 1965  
Betty Corbin Notary Public.

Drillers Well Log

Davis Brothers & Transit Corporation - Ordway #1 - "H" Located in SE SW NE, - section 20-103-18 -  
Rocks County, Kansas.

Commenced: December 9, 1957  
Completed: December 20, 1957  
Elevation: 2149'-D.F.

Casing - 8 5/8" @ 196'  
Cemented 125 sacks  
5 1/2" @ 3738' with  
200 sacks Pozmix -

<u>Formation</u>	<u>From</u>	<u>To</u>
Shale and Shells	0	120
Sand	120	180
Shale	180	450
Shale and Shells	450	1036
Sand	1036	1193
Shall and Shells	1193	1525
Anhydrite	1525	1560
Shale	1560	2011
Shale and Lime Streaks	2011	2220
Shale and Lime	2220	2565
Shale and Lime Streaks	2565	2826
Shale	2826	2905
Shale and Lime	2905	3036
Shale	3036	3114
Shale and Lime	3114	3317
Line and Shale Streaks	3317	3346
Heebner	3346	3349
Hard Line	3349	3352
Line	3352	3469
Hard Line	3469	3515
Line	3515	3553
Line and Shale	3553	3646
Conglomerate	3646	3712
Line	3712	3741 F.D.

Formation Tops

Topoka	3128'
Heebner	3349'
Toronto	3361'
Lensing	3389'
Base of KC3610'	
Conglomerate	3642'

RECEIVED  
STATE CORPORATION COMMISSION

OCT 7 1964

CONSERVATION DIVISION  
Wichita, Kansas

I hereby certify the foregoing to be a true and accurate Driller's Log of the formation encountered in the above well.

TRANSIT CORPORATION

Subscribed and sworn to before me this  
3rd day of January, 1958.

My commission expires July 1, 1959

By [Signature]

[Signature]  
Notary Public