


STATE OF KANSAS
STATE CORPORATION COMMISSION

WELL PLUGGING RECORD

Give All Information Completely
Make Required Affidavit
Mail or Deliver Report to:
Conservation Division
State Corporation Commission
212 No. Market
Wichita, Kansas

Rooks County. Sec. 20 Twp. 10 Rge. (E) 18 (W)
Location as "NE/CNW/SW" or footage from lines NE SE NW
Lease Owner Price Exploration Company
Lease Name Andreson "A" Well No. 1
Office Address 404 Oil Capital Bldg, Tulsa, Oklahoma
Character of Well (completed as Oil, Gas or Dry Hole) Dry
Date well completed December 19 19 67
Application for plugging filed December 19 19 67
Application for plugging approved December 19 19 67
Plugging commenced December 19 19 67
Plugging completed December 19 19 67
Reason for abandonment of well or producing formation Dry

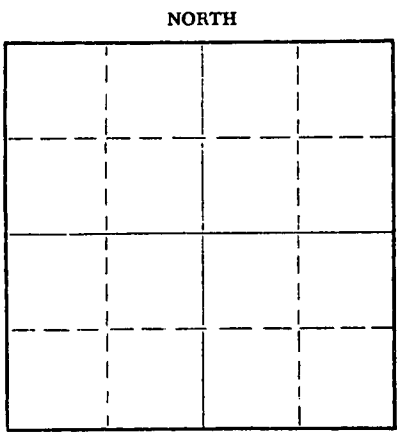

Locate well correctly on above
Section Plat

If a producing well is abandoned, date of last production _____ 19____
Was permission obtained from the Conservation Division or its agents before plugging was commenced? Yes

Name of Conservation Agent who supervised plugging of this well Leo F. Massey
Producing formation _____ Depth to top _____ Bottom _____ Total Depth of Well 3755 Feet
Show depth and thickness of all water, oil and gas formations.

OIL, GAS OR WATER RECORDS CASING RECORD

FORMATION	CONTENT	FROM	TO	SIZE	PUT IN	PULLED OUT
				8 5/8"	207'	
					DEC 26 1967	
					12-26-67	

Describe in detail the manner in which the well was plugged, indicating where the mud fluid was placed and the method or methods used in introducing it into the hole. If cement or other plugs were used, state the character of same and depth placed, from _____ feet to _____ feet for each plug set.

Bottom Plug @ 800' with 100 sx.
Middle Plug @ 210' with 25 sx.
Top Plug @ 40' with 10 sx.

(If additional description is necessary, use BACK of this sheet)

Name of Plugging Contractor Woodman & Iannitti Drilling Company
Address 706 Union National Building

STATE OF KANSAS, COUNTY OF SEDGWICK, ss.
K. T. WOODMAN (employee of owner) or (owner or operator) of the above-described well, being first duly sworn on oath, says: That I have knowledge of the facts, statements, and matters herein contained and the log of the above-described well as filed and that the same are true and correct. So help me God.

(Signature) K. T. Woodman
706 Union National Building
(Address)

SUBSCRIBED AND SWORN to before me this 22nd day of December, 1967

My commission expires Feb. 11, 1968

Justina Chamberlain
Justina Chamberlain Notary Public.

15-163-20084 0000

KANSAS GEOLOGICAL SOCIETY
KANSAS WELL LOG BUREAU - KANSAS WELL SAMPLE BUREAU
 KANSAS GEOLOGICAL SOCIETY BUILDING
 508 EAST MURDOCK - WICHITA, KANSAS

COMPANY Price Exploration Company


SEC. 20 T. 10 R. 18W
 LOC. NE SE NW

FARM Andreson "A" NO. 1

TOTAL DEPTH 3755'
 COMM. Dec. 11, 1967 COMP. Dec. 19, 1967
 SHOT OR TREATED
 CONTRACTOR Woodman & Iannitti Drilling Co.
 ISSUED

COUNTY Rooks

KANSAS

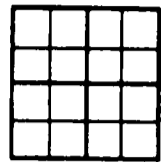

CASING
 20 10
 15 8 @ 207'
 12 6
 13 5

ELEVATION 2129 K.B.

PRODUCTION D & A

FIGURES INDICATE BOTTOM OF FORMATIONS

30	Clay & Post Rock
180	Post Rock & Shale
207	Shale
440	Shale
850	Shale
1195	Sand
1340	Red Bed
1519	Red Bed
1546	Anhy
1750	Shale & Shells
2170	Shale & Shells
2310	Lime
2455	Lime
2560	Lime
2735	Lime
2845	Lime
2935	Lime
3090	Lime
3190	Lime
3245	Lime
3315	Lime
3370	Lime
3422	Lime
3485	Lime
3535	Lime
3580	Lime
3615	Lime
3635	Lime
3706	Lime
3735	Arbuckle
3755	Arbuckle

DEC 26 1967
 WOODMAN & IANNITTI DRILLING CO.

I certify the above to be a true and correct copy of the driller's log and the geological tops to the best of my knowledge and belief.

Woodman & Iannitti Drilling Co.

K. T. Woodman
 K. T. Woodman