


WELL PLUGGING RECORD

Give All Information Completely
Make Required Affidavit
Mail or Deliver Report to:
Conservation Division
State Corporation Commission
212 North Market, Insurance Bldg.
Wichita, Kansas

Rooks County, Sec. 21 Twp 10S Rge. 18 (E) 11 (W)
Location as "NE/CNW/SW" or footage from lines C SE SE
Lease Owner Davis Bros.
Lease Name Ordway "H" Well No. 1
Office Address 11 East 3rd. St., Tulsa, Oklahoma
Character of Well (completed as Oil, Gas or Dry Hole) D & A
Date well completed September 8, 19 59
Application for plugging filed September 8, 19 59
Application for plugging approved September 8, 19 59
Plugging commenced September 8, 19 59
Plugging completed September 8, 19 59
Reason for abandonment of well or producing formation No production

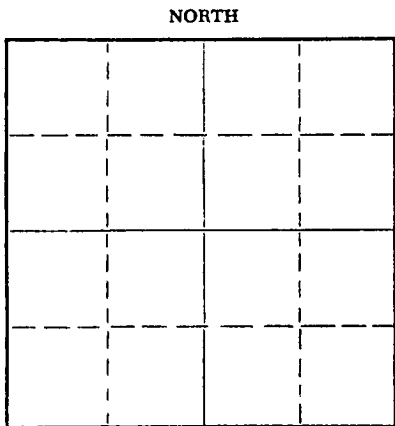

Locate well correctly on above
Section Plat

If a producing well is abandoned, date of last production 19
Was permission obtained from the Conservation Division or its agents before plugging was com-
menced? Yes

Name of Conservation Agent who supervised plugging of this well Eldon Petty-Box 326, Hays, Kansas
Producing formation _____ Depth to top _____ Bottom _____ Total Depth of Well _____ Feet
Show depth and thickness of all water, oil and gas formations.

OIL, GAS OR WATER RECORDS

CASING RECORD

| FORMATION | CONTENT | FROM | TO | SIZE | PUT IN | PULLED OUT |
|-----------|---------|------|----|--------|--------|------------|
| | | | | 8 5/8" | 150" | None |
| | | | | | | |
| | | | | | | |
| | | | | | | |
| | | | | | | |
| | | | | | | |
| | | | | | | |

Describe in detail the manner in which the well was plugged, indicating where the mud fluid was placed and the method or methods used in introducing it into the hole. If cement or other plugs were used, state the character of same and depth placed, from _____ feet to _____ feet for each plug set.

Filled hole with heavy drilling mud to 500'; set plug, cemented with 20 sacks cement
Filled hole with heavy drilling mud to 145'; set plug, cemented with 15 sacks cement
Filled hole with heavy drilling mud to 40'; set plug, cemented with 10 sacks cement to bottom of collar

12-16-59
DEC 16 1959
CONSERVATION DIVISION
Wichita, Kansas

(If additional description is necessary, use BACK of this sheet)

Name of Plugging Contractor Transit Corporation
Address 1516 Liberty Bank Building, Oklahoma City, Oklahoma

STATE OF Oklahoma, COUNTY OF Oklahoma, ss.
Paul E. Gathers (employee of owner) or (owner or operator) of the above-described well, being first duly sworn on oath, says: That I have knowledge of the facts, statements, and matters herein contained and the log of the above-described well as filed and that the same are true and correct. So help me God.

(Signature) Paul E. Gathers

(Address)

SUBSCRIBED AND SWORN TO before me this 21st. day of September, 19 59

Richard [Signature]

My commission expires May 17, 1962

Notary Public.



DRILLER'S WELL LOG

Davis Bros.-Ordway "H" # 1 well located in
C S^W SE Section 21-10S-18W,
Rooks County, Kansas

Commenced: August 29, 1959
Completed: September 8, 1959
Elevation: 2109' KB

Casing 8 5/8" @ 150'
Cemented w/115 sacks

| <u>Formation</u> | <u>From</u> | <u>To</u> |
|-----------------------|-------------|-----------|
| Rock | 0 | 40 |
| Shale | 40 | 110 |
| Sand | 110 | 128 |
| Shale | 128 | 152 |
| Shale and shells | 152 | 925 |
| Sand | 925 | 1125 |
| Shale (Red bed) | 1125 | 1455 |
| Shale | 1455 | 1460 |
| Anhydrite | 1460 | 1490 |
| Shale | 1490 | 2097 |
| Lime and shale | 2097 | 2400 |
| Lime and shale | 2400 | 2435 |
| Salt | 2435 | 2475 |
| Shale w/lime streaks | 2475 | 2630 |
| Lime and shale | 2630 | 2710 |
| Shale w/lime streaks | 2710 | 3085 |
| Lime | 3085 | 3210 |
| Lime and shale | 3210 | 3280 |
| Lime | 3280 | 3598 |
| Lime and conglomerate | 3598 | 3628 |
| Conglomerate | 3628 | 3705 |
| Lime | 3705 | 3728 TD |

Summary of Formation

| | |
|--------------|-------|
| Anhydrite | 1464' |
| Topeka | 3082' |
| Heebner | 3300' |
| Toronto | 3324' |
| Lansing-K.C. | 3346' |
| Base of K.C. | 3568' |
| Conglomerate | 3608' |
| Simpson | 3678' |
| Arbuckle | 3702' |

RECORDED
STATE OF KANSAS

DEC 16 1959

CONSERVATION DIVISION
Wichita, Kansas

I hereby certify the foregoing to be a true and accurate Driller's Log of the formation encountered in the above well.

Subscribed and sworn to before me
this 22nd. day of September, 1959.

TRANSIT CORPORATION

BY Paul E. Gahero

My Commission expires May 17, 1962.

Mildred Egan
Notary Public