

NOTICE OF INTENTION TO DRILL

(see rules on reverse side)

Expected Spud Date. 6 month 8 day 87 year

API Number 15- 163-22,926-0000

OPERATOR: License # 5537
Name Kenny Brown Enterprises
Address Drawer 340
City/State/Zip Plainville, Kansas 67663
Contact Person Kenneth O Brown
Phone 913-434-7236

SE SE NE Sec. 22 Twp. 10 S, Rg. 18 X West
2970 Ft. from South Line of Section
330 Ft. from East Line of Section

(Note: Locate well on Section Plat on reverse side)

Nearest lease or unit boundary line 330 feet
County Rooks
Lease Name Garvert Well # 7

CONTRACTOR: License # 5145
Name Dreiling Oil, Inc.
City/State Victoria, Kansas 67671

Ground surface elevation 2119 feet MSL
Domestic well within 330 feet: yes X no

Well Drilled For: Well Class: Type Equipment:
X Oil Storage X Infield X Mud Rotary
Gas Inj Pool Ext Air Rotary
OWWO Expl Wildcat Cable

Municipal well within one mile: yes X no
Depth to bottom of fresh water 125'

If OWWO: old well info as follows:
Operator
Well Name
Comp Date Old Total Depth

Depth to bottom of usable water 900'
Surface pipe by Alternate: 1 2 X

I certify that well will comply with K.S.A. 55-101, et seq., plus eventually plugging hole to KCC specifications.
Date 6-2-87 Signature of Operator or Agent Vicki E. Brown Title Office Manager

For KCC Use:
Conductor Pipe Required feet; Minimum Surface Pipe Required 200 feet per Alt. # 2
This Authorization Expires 12-3-87 Approved By 6-3-87


Handwritten signature and initials at bottom right.

Must be filed with the K.C.C. five (5) days prior to commencing well
 This card void if drilling not started within six (6) months of date received by K.C.C.

Important procedures to follow:

1. Notify District office before setting surface casing.
2. Set surface casing by circulating cement to the top.
3. File completion forms ACO-1 with K.C.C. within 120 days of well spud date, following instructions on ACO-1, side 1, and including copies of wireline logs.
4. Notify District office 48 hours prior to old well workover or re-entry.
5. Prior to filing Intent, prepare a proposed plugging plan in case well is Is & A, then obtain approval of plan when calling district office prior to setting surface pipe.
6. Submit plugging report (CP-4) to K.C.C. after plugging is completed.
7. Obtain an approved injection docket number before disposing of salt water.
8. Notify K.C.C. within 10 days when injection commences or terminates.
9. If an alternate 2 completion, cement in the production pipe from below any usable water to surface within 120 days of spud date.

**A Regular Section of Land
 1 Mile = 5,280 Ft.**

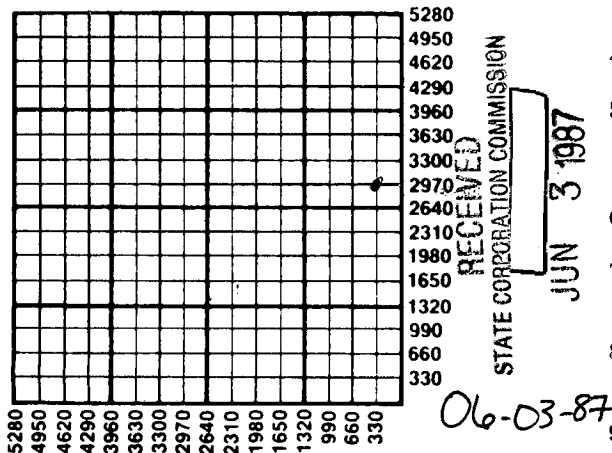

State Corporation Commission of Kansas
 Conservation Division
 200 Colorado Derby Building
 Wichita, Kansas 67202-1212
 (316) 263-3238