


Give All Information Completely
Make Required Affidavit
Mail or Deliver Report to:
Conservation Division
State Corporation Commission
212 No. Market
Wichita, Kansas

WELL PLUGGING RECORD

Rooks County, Sec. 23 Twp. 10S Rge. 18 (W)

Location as "NE/CNW/SW" or footage from lines SW SENE Rooks County
Lease Owner Davis Bros. Oil Producers
Lease Name Shepard A Well No. 1
Office Address 510 Mc Farlin Building Tulsa, Oklahoma
Character of Well (completed as Oil, Gas or Dry Hole) Input
Date well completed 9-8-1958 1958
Application for plugging filed 11-21 1966
Application for plugging approved 11-22- 1966
Plugging commenced 11-21 1966
Plugging completed 11-21 1966
Reason for abandonment of well or producing formation Lost Hole

If a producing well is abandoned, date of last production 11-15 1966
Was permission obtained from the Conservation Division or its agents before plugging was commenced? Yes

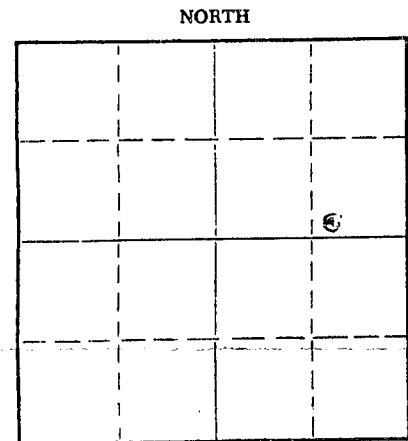

Locate well correctly on above
Section Plat

Name of Conservation Agent who supervised plugging of this well Leo Massey
Producing formation Kansas City Depth to top 3344 Bottom 3567 Total Depth of Well 3709 Feet
Show depth and thickness of all water, oil and gas formations.


OIL, GAS OR WATER RECORDS

CASING RECORD

FORMATION	CONTENT	FROM	TO	SIZE	PUT IN	PULLED OUT

Describe in detail the manner in which the well was plugged, indicating where the mud fluid was placed and the method or methods used in introducing it into the hole. If cement or other plugs were used, state the character of same and depth placed, from _____ feet to _____ feet for each plug set.

Squeezed Through 8 1/2" Plug Container w/ 40 bbl. Gel. and 100 sacks
of 50-50 Pozmix Cement at Surface.
Bottom Squeezed w/ 275 sack Pozmix Cement while attempting
To Cement Liner in Well

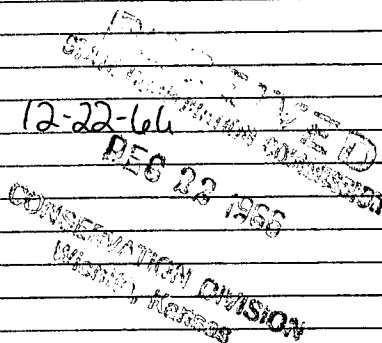

(If additional description is necessary, use BACK of this sheet)

Name of Plugging Contractor Company Tools with Halliburton Company
Address Atys, Kansas

STATE OF Kansas, COUNTY OF Rooks, ss.
Charles G. Arnold (employee of owner) or (owner or operator) of the above-described
well, being first duly sworn on oath, says: That I have knowledge of the facts, statements, and matters herein contained and the log of the
above-described well as filed and that the same are true and correct. So help me God.

(Signature) Charles G. Arnold

Plainville, Kansas
(Address)

SUBSCRIBED AND SWORN to before me this 15th day of December, 19 66

My commission expires Nov. 16, 1968

Alvin Mai
Notary Public.