


Give All Information Completely
Make Required Affidavit
Mail or Deliver Report to:
Conservation Division
State Corporation Commission
211 No. Broadway
Wichita, Kansas

WELL PLUGGING RECORD

NORTH

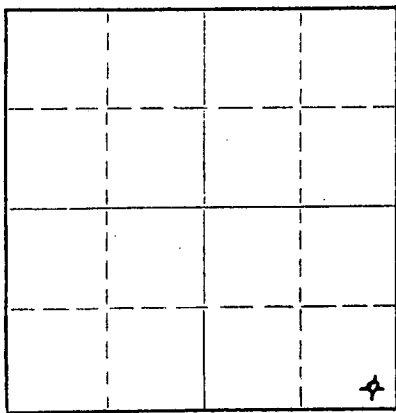

Locate well correctly on above
Section Plat

Rooks County. Sec. 22 Twp. 10 Rge. 18 (E) W (W)
Location as "NE/CNW/SW" or footage from lines SE SE SE
Lease Owner Fred J. Haynes
Lease Name Shepard Well No. 1
Office Address Bldg. & Loan Bldg. Russell, Kansas
Character of Well (completed as Oil, Gas or Dry Hole) Dry Hole
Date well completed 9-15-56 19
Application for plugging filed 9-14-56 19
Application for plugging approved 9-15-56 19
Plugging commenced 9-15-56 19
Plugging completed 9-15-56 19
Reason for abandonment of well or producing formation D & A

If a producing well is abandoned, date of last production 19
Was permission obtained from the Conservation Division or its agents before plugging was commenced? Yes

Name of Conservation Agent who supervised plugging of this well Mr. Eldon Petty, Box 326, Hays, Kansas
Producing formation _____ Depth to top _____ Bottom _____ Total Depth of Well 3500 Feet
Show depth and thickness of all water, oil and gas formations. 3418

OIL, GAS OR WATER RECORDS

ZTKC CASING RECORD

FORMATION	CONTENT	FROM	TO	SIZE	PUT IN	PULLED OUT
				5 1/2"	3500+	2800+
					3418	2750

Describe in detail the manner in which the well was plugged, indicating where the mud fluid was placed and the method or methods used in introducing it into the hole. If cement or other plugs were used, state the character of same and depth placed, from _____ feet to _____ feet for each plug set.

Set plug at 180' and cemented with 15 sacks - set filled with mud - set
plug at 40' and cemented with 10 sacks.

(If additional description is necessary, use BACK of this sheet)

Name of Plugging Contractor Fred J. Haynes
Address Bldg. & Loan Bldg. Russell, Kansas

STATE OF Kansas, COUNTY OF Russell, ss.
Darrell E. Haynes (employee of owner) or (owner or operator) of the above-described well, being first duly sworn on oath, says: That I have knowledge of the facts, statements, and matters herein contained and the log of the above-described well as filed and that the same are true and correct. So help me God.

(Signature) Darrell E. Haynes
(Address)

SUBSCRIBED AND SWORN to before me this 21st day of September, 1956

Ralph L. Shultz
Notary Public.

My commission expires January 17, 1957.

PLUGGING
FILE SEC 22 T. 10 R18W
BOOK PAGE 100 LINE 37

9-24-56