


Information Completely
Required Affidavit
or Deliver Report to:
Conservation Division
State Corporation Commission
800 Biting Building
Wichita, Kansas

WELL PLUGGING RECORD

Rooks _____ County. Sec. 22 Twp. 10 Rge. 18 (E) _____ (W) _____
Location as "NE/CNW/SW" or footage from lines SE SE SE
Lease Owner Musgrove Petroleum Corporation
Lease Name Shepard Well No. 1
Office Address 518 Petroleum Building, Wichita, Kansas.
Character of Well (completed as Oil, Gas or Dry Hole) Dry Hole
Date well completed August 5, 1953
Application for plugging filed August 5, 1953
Application for plugging approved August 5, 1953
Plugging commenced August 5, 1953
Plugging completed August 5, 1953
Reason for abandonment of well or producing formation Dry Hole

NORTH

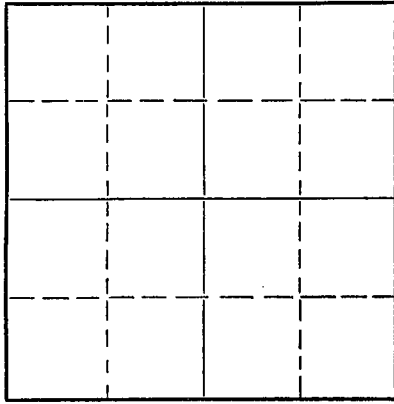

Locate well correctly on above
Section Plat.

If a producing well is abandoned, date of last production _____ 19____
Was permission obtained from the Conservation Division or its agents before plugging was com-
menced? _____ Yes

Name of Conservation Agent who supervised plugging of this well _____
Producing formation _____ Depth to top _____ Bottom _____ Total Depth of Well 3685 Feet
Show depth and thickness of all water, oil and gas formations.

OIL, GAS OR WATER RECORDS

CASING RECORD

FORMATION	CONTENT	FROM	TO	SIZE	PUT IN	PULLED OUT
				8-5/8"	188'	

Describe in detail the manner in which the well was plugged, indicating where the mud fluid was placed and the method or methods used in introducing it into the hole. If cement or other plugs were used, state the character of same and depth placed, from _____ feet to _____ feet for each plug set.

Set bottom plug at 180' with 15 sacks cement
Set top plug at 140' with 10 sacks cement

(If additional description is necessary, use BACK of this sheet)

Name of Plugging Contractor Musgrove Petroleum Corporation
Address 518 Petroleum Building, Wichita, Kansas.

STATE OF Kansas, COUNTY OF Sedgwick
L. Gordon L. Koelling (employee of owner) or (owner/operator) of the above-described well, being first duly sworn on oath, says: That I have knowledge of the facts, statements, and matters herein contained and the log of the above-described well as filed and that the same are true and correct. So help me God.


(Signature) L. Gordon L. Koelling
518 Petroleum Building, Wichita, Kansas.
(Address)

SUBSCRIBED AND SWORN TO before me this 10th day of August, 1953

My commission expires September 24, 1954

24-7368-S 3-53-20M

Notary Public.

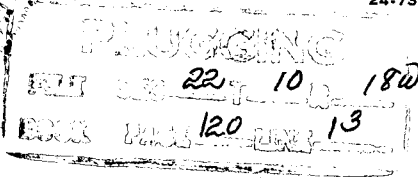

8-12-53

CONTRACTOR'S WELL LOG

COMPANY: Musgrove Petroleum Corporation
 CONTRACTOR: Musgrove Petroleum Corporation
 FARM: SHEPARD #1
 LOCATION: SE SE SE Sec. 22-10-18
 Rocks County, Kansas.
 COMMENCED: July 22, 1953
 COMPLETED: August 5, 1953

0	15	Cellar & limestone
15	130	Blue shale
130	188	Shale & shell
188	1050	Shale & sand
1050	1410	Shale & shells
1410	1450	Anhydrite
1450	1980	Shale & shells
1980	2780	Lime & shale
2780	2895	Shale
2895	3110	Shales lime
3110	3250	Shale & lime
3250	3299	Limed shale
3299	3416	Lime
3416	3540	Lime & shale
3540	3606	Limed, shaled chert
3606	3631	Chert
3631	3655	Lime, shale & chert
3655	3685	Lime
	3685	Rotary Total Depth

Set 8-5/8" surface casing at 188' with 125 sacks cement.

Dry and Abandoned

STATE OF KANSAS)
) SS
 COUNTY OF SEDGWICK)

I, GORDON L. KOELLING, do hereby certify that the above and foregoing is a true and correct copy of the log of the Shepard #1, SE SE SE, Sec. 22-10-18, Rooks County, Kansas, as reflected by the files of the Musgrove Petroleum Corporation.

MUSGROVE PETROLEUM CORPORATION

BY *Gordon L. Koelling*
 Secretary-Treasurer

Subscribed and sworn to before me, a Notary Public, in and for Sedgwick County, Kansas, this 10th day of August, 1953.

William L. Stencamp
 Notary Public

My commission expires September 24, 1956.

PLUGGING
 FILE SEC 22 T 10 R 180
 BOOK PAGE 120 LINE 13