


STATE OF KANSAS
STATE CORPORATION COMMISSION

WELL PLUGGING RECORD

Give All Information Completely
Make Required Affidavit
Mail or Deliver Report to
Conservation Division
State Corporation Comm.
245 North Water
Wichita, KS 67202

Rooks County, Sec. 22 Twp. 10 Rge. 18 E/W
Location as "NE/CNW $\frac{1}{4}$ SW $\frac{1}{4}$ " or footage from lines

SE SW NW
Lease Owner Kenny Brown Enterprises
Lease Name Garvette Well No. 4
Office Address P. O. Drawer 340, Plainville, KS 67663
Character of Well (Completed as Oil, Gas or Dry Hole) Dry Hole

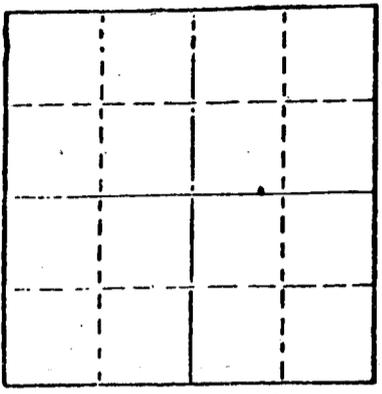

Locate well correctly on above Section Plat

Date Well completed 11-22 1981
Application for plugging filed 11-22 1981
Application for plugging approved 11-22 1981
Plugging commenced 11-22 1981
Plugging completed 11-22 1981
Reason for abandonment of well or producing formation _____

If a producing well is abandoned, date of last production _____ 19 _____

Was permission obtained from the Conservation Division or its agents before plugging was commenced? Yes _____

Name of Conservation Agent who supervised plugging of this well Marion Schmidt
Producing formation _____ Depth to top _____ Bottom _____ Total Depth of Well 3480'
Show depth and thickness of all water, oil and gas formations.

OIL, GAS OR WATER RECORDS

CASING RECORD

FORMATION	CONTENT	FROM	TO	SIZE	PUT IN	PULLED OUT
				8 5/8"	169'	-0-

Describe in detail the manner in which the well was plugged, indicating where the mud fluid was placed and the method or methods used in introducing it into the hold. If cement or other plugs were used, state the character of same and depth placed, from _____ feet to _____ feet for each plug set.

1st plug was set at 870' with 70 sacks cement
2nd plug was set at 240' with 40 sacks cement
3rd plug was set at 40' with 10 sacks cement


(If additional description is necessary, use BACK of this sheet)

Name of Plugging Contractor Dreiling Oil, Inc., Victoria, KS 67671

STATE OF KANSAS COUNTY OF ELLIS, ss.
I, Patty Dreiling, of Dreiling Oil, Inc. (employee of owner) or (owner or operator)

of the above-described well, being first duly sworn on oath, says: That I have knowledge of the facts, statements, and matters herein contained and the log of the above-described well as filed and that the same are true and correct. So help me God.

(Signature) Patty Dreiling
Patty Dreiling, Victoria, KS 67671
(Address)

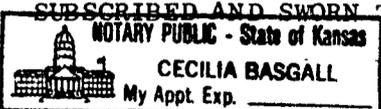

SUBSCRIBED AND SWORN TO before me this 25th day of November, 19 81

Cecilia Basgall Notary Public.
My commission expires January 19, 1985

RECEIVED
STATE CORPORATION COMMISSION
12-7-81
DEC - 7 1981

CONSERVATION DIVISION
Wichita, Kansas