


STATE OF KANSAS
STATE CORPORATION COMMISSION
CONSERVATION DIVISION
P. O. BOX 17027
WICHITA, KANSAS 67217

WELL PLUGGING RECORD

Rooks County. Sec. 24 Twp. 10 S Rge. 18 (E) W (W)
Location as "NE/CNW/SW" or footage from lines _____
Lease Owner Davis Brothers Oil Producers, Inc.
Lease Name Shepard "A" Well No. 2
Office Address 500 McFarlin Building- Tulsa, Oklahoma-74103
Character of Well (completed as Oil, Gas or Dry Hole) Oil
Date well completed October 17, 1958 19____
Application for plugging filed October 20, 1976
Application for plugging approved October 20, 1976
Plugging commenced October 21, 1976
Plugging completed October 21, 1976
Reason for abandonment of well or producing formation Unable to return to working Inj. well after workover, because of bad casing.
If a producing well is abandoned, date of last production NA 19____
Was permission obtained from the Conservation Division or its agents before plugging was commenced? Yes

NORTH

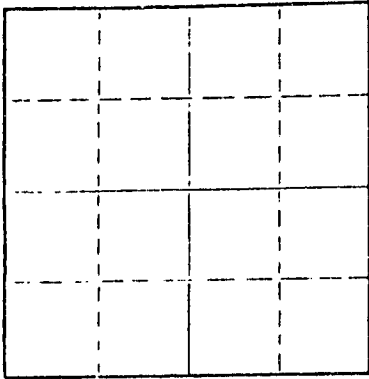

Locate well correctly on above Section Plot

Name of Conservation Agent who supervised plugging of this well Leo Massey
Producing formation Lansing-Kansas City Depth to top 3220' Bottom 3546' Total Depth of Well 3902'
Show depth and thickness of all water, oil and gas formations.

OIL, GAS OR WATER RECORDS

CASING RECORD

FORMATION	CONTENT	FROM	TO	SIZE	PUT IN	PULLED OUT
				8 5/8"	170'	None
				4 1/2"	3893'	38'

Describe in detail the manner in which the well was plugged, indicating where the mud fluid was placed and the method or methods used in introducing it into the hole. If cement or other plugs were used, state the character of same and depth placed, from _____ feet to _____ feet for each plug set.

Circulated well full of Gel Mud, from surface to T.D., with 2 3/8" tubing at 3000'. Pumped and spotted 100 sacks of 60-40 Poz-Mix Class A cement from 3000' to T.D. Displaced cement out of tubing, with Gel Mud to 3000'. Pulled tubing from well. Prepared surface casing with 4 1/2" casing nipple. Pumped 70 Bbls. of Gel Mud to 400 P.S.I., followed by 150 sacks of cement into surface casing. Shut well in with 200 P.S.I.

(If additional description is necessary, use BACK of this sheet)

Name of Plugging Contractor Halliburton Services
Address Hays, Kansas

STATE OF OKLAHOMA COUNTY OF TULSA ss.

_____, (employee of owner) or (owner/operator) of the above-described well, being first duly sworn on oath, says: That I have knowledge of the facts, statements, and matters herein contained and the log of the above-described well as filed and that the same are true and correct. So help me God.

(Signature) Joseph J. Lawnick Joseph J. Lawnick

500 McFarlin Bldg, Tulsa, Okla. 74103
(Address)

SUBSCRIBED AND SWORN TO before me this 14th day of November, 1976

My commission expires Aug. 6, 1977

Melody M. Sullivan
Notary Public.

