

15-163-21014-0000


STATE OF KANSAS  
STATE CORPORATION COMMISSION

WELL PLUGGING RECORD

Give All Information Completely  
Make Required Affidavit  
Mail or Deliver Report to  
Conservation Division  
State Corporation Comm.  
245 North Water  
Wichita, KS 67202

Rooks County, Sec. 27 Twp. 10 Rge. 18 E/W  
Location as "NE/CNW $\frac{1}{4}$ /SW $\frac{1}{4}$ " or footage from lines  
SW SE SE

Lease Owner Montgomery Drilling Program  
Lease Name Eilers Well No. 2  
Office Address 235 Montgomery St. Suite 1114  
San Francisco, Ca.  
Character of Well (Completed as Oil, Gas or Dry Hole) dry hole

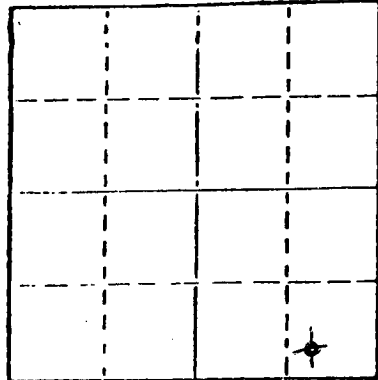

Locate well correctly on above  
Section Plat

Date Well completed March 19 1980  
Application for plugging filed March 19 1980  
Application for plugging approved March 19 1980  
Plugging commenced March 19 1980  
Plugging completed March 19 1980  
Reason for abandonment of well or producing formation dry hole

If a producing well is abandoned, date of last production 19

Was permission obtained from the Conservation Division or its agents before plugging was commenced? yes

Name of Conservation Agent who supervised plugging of this well Marion Schmidt  
Producing formation \_\_\_\_\_ Depth to top \_\_\_\_\_ Bottom \_\_\_\_\_ Total Depth of Well 3740'  
Show depth and thickness of all water, oil and gas formations.

OIL, GAS OR WATER RECORDS

CASING RECORD

FORMATION	CONTENT	FROM	TO	SIZE	PUT IN	PULLED OUT
surface		0	230	85/8"	213	0


Describe in detail the manner in which the well was plugged, indicating where the mud fluid was placed and the method or methods used in introducing it into the hold. If cement or other plugs were used, state the character of same and depth placed, from \_\_\_\_\_ feet to \_\_\_\_\_ feet for each plug set.

1st Plug set 900' with 70 sacks cement 50-50 poz 4% gel.

2nd Plug set 200' with 20 sacks cement 50-50 poz 4% gel.

3rd Plug set 40' with 10 sacks cement 50-50 poz 4% gel.

5 sacks in rathole

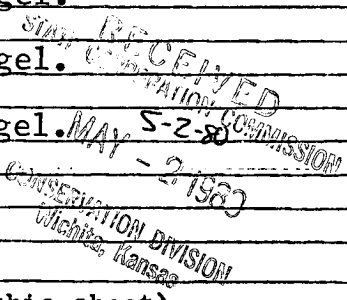

(If additional description is necessary, use BACK of this sheet)

Name of Plugging Contractor Allied Cementing Co., Inc.

STATE OF Kansas COUNTY OF Graham, ss.  
Jerry M. Helberg (employee of owner) or (owner or operator)  
of the above-described well, being first duly sworn on oath, says: That I have knowledge of the facts, statements, and matters herein contained and the log of the above-described well as filed and that the same are true and correct. So help me God.

(Signature) Jerry M. Helberg  
Box 32 Morland, Kansas 67650  
(Address)

SUBSCRIBED AND SWORN TO before me this 1st 26th day of March May, 1980

James Robinson  
Notary Public.

My commission expires Dec. 4, 1983



15-163-21014-0000

DRILLERS LOG

EILERS #2

CASING RECORD:

8 5/8" set at 213'

OPERATOR: Montgomery Drilling Program

CONTRACTOR: Helberg Oil Company

TOTAL DEPTH:

3740'

COMMENCED: March 8, 1980

COMPLETED: March 19, 1980

DESCRIPTION:

SW SE SE  
Sec. 27-10-18, Rooks, County, Kansas

FORMATION	FROM	TO	REMARKS
Shale	0	230	
Sand & Shale	230	412	
Sand & Shale	412	1124	
Sand & Shale	1124	1412	
Anhydrite	1412	1446	
Sand & Shale	1446	1483	
Sand & Shale	1483	1790	
Lime & Shale	1790	2050	
Lime & Shale	2050	2161	
Shale & Lime	2161	2327	
Lime & Shale	2327	2460	
Lime & Shale	2460	2611	
Shale & Lime	2611	2740	
Lime & Shale	2740	2855	
Lime & Shale	2855	2961	
Lime & Shale	2961	3075	
Lime & Shale	3075	3139	
Lime & Shale	3139	3216	
Lime & Shale	3216	3240	
Lime & Shale	3240	3306	
Lime & Shale	3306	3325	
Lime & Shale	3325	3352	
Lime	3352	3370	
Lime	3370	3394	
Lime	3394	3420	
Lime	3420	3485	
Lime	3485	3521	
Lime	3521	3530	
Sand & Shale	3530	3597	
Shale	3597	3661	
Shale	3661	3740	
T.D.	3740		D & A

STATE COM. RECEIVED  
MAY 1980  
CONSERVATIVE

I certify that the above is a true and correct copy of the log to the best of my knowledge.

HELBERG OIL COMPANY

*Jerry M. Helberg*  
Jerry M. Helberg

Subscribed and sworn to before me this 29th day of April, 1980.

*James L. Schmeier*  
Notary Public

My commission expires Dec. 4, 1983

