


WELL PLUGGING RECORD

Give All Information Completely
Make Required Affidavit
Mail or Deliver Report to:
Conservation Division
State Corporation Commission
800 Bitting Building
Wichita, Kansas

ROOKS County. Sec. 26 Twp. 10 Rge. 18 (E) W (W)
Location as "NE/CNW $\frac{1}{4}$ SW $\frac{1}{4}$ " or footage from lines SW SW NE/4
Lease Owner M. & L. Oil Company
Lease Name Wiesner Well No. 1
Office Address 211 Brown Building, Wichita, Kans.
Character of Well (completed as Oil, Gas or Dry Hole) Dry hole
Date well completed March 31 1951
Application for plugging filed March 31 1951
Application for plugging approved March 31 1951
Plugging commenced March 31 1951
Plugging completed March 31 1951
Reason for abandonment of well or producing formation too low structurally

NORTH

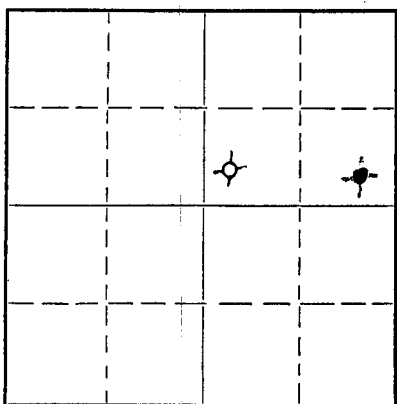

Locate well correctly on above Section Plat

If a producing well is abandoned, date of last production 19...
Was permission obtained from the Conservation Division or its agents before plugging was commenced? yes

Name of Conservation Agent who supervised plugging of this well Eldon Petty, Hays, Kans
Producing formation Depth to top Bottom Total Depth of Well Feet
Show depth and thickness of all water, oil and gas formations.

OIL, GAS OR WATER RECORDS

CASING RECORD

Formation	Content	From	To	Size	Put In	Pulled Out
				8 5/8"	220.16' (28#)	

Describe in detail the manner in which the well was plugged, indicating where the mud fluid was placed and the method or methods used in introducing it into the hole. If cement or other plugs were used, state the character of same and depth placed, from...feet to...feet for each plug set.

Filled with drilling mud to 220'. Put in 15 sacks cement then pumped full of mud 25' from top of hole. Drove plug down to 25' then filled to top with 10 sacks of cement.

45-51

(If additional description is necessary, use BACK of this sheet)

Correspondence regarding this well should be addressed to M. & L. Oil Company
Address 211 Brown Building, Wichita, Kans.

STATE OF Kansas, COUNTY OF Sedgwick, ss.
R. A. Cook (employee of owner) or ~~owner or operator~~ of the above-described well, being first duly sworn on oath, says: That I have knowledge of the facts, statements and matters herein contained and the log of the above-described well as filed and that the same are true and correct. So help me God.

(Signature) *R A Cook*
206 Union National Bank Bldg.
(Address)

SUBSCRIBED AND SWORN to before me this 2nd day of April, 1951

Almeda Howe
Notary Public.

My commission expires August 11, 1954

PLUGGING
FILE SEC 26 T 10 R 18 W
BOOK PAGE 70 LINE 43

15-163-00345-0000

CONTRACTOR'S WELL LOG

Operator M. & L. Oil Company Farm Name Wiesner
Location SW SW NE/4 Sec. 26-10-18W
Pool Name WC County Rooks State Kansas
Commencement Date 3-18-51 Completion Date 3-31-51

LOG OF WELL

Elevation 2111 R. B.
All Measurements from the top of rotary bushing.

DEPTH		FORMATION	DEVIATION	REMARKS:
FROM	TO		FROM VERTICAL	
0	165			
165	220			
220	805	Shale-Shells-Sand		
805	900	Sand		
900	935	Shale-Shells		
935	1110	Sand		
1110	1305	Redbed		
1305	1455	Redbed		
1455	1490	Anhydrite		
1490	1705	Shale-Shells	1500-00	
1705	2010	Shale-Shells		
2010	2135	Lime-Shale		
2135	2310	Shale-Lime		
2310	2400	Lime-Shale		
2400	2510	Lime-Shale	2500-00	
2510	2630	Lime-Shale		
2630	2745	Lime-Shale		
2745	2850	Lime-Shale		
2850	2970	Shale-Lime		
2970	3065	Shale-Lime		
3065	3120	Shale-Lime	3000-00	
3120	3175	Lime-Shale		
3175	3250	Lime-Shale		
3250	3297	Lime-Shale		
3297	3345	Lime-Shale		
3345	3400	Lime-Shale		
3400	3455	Lime		
3455	3483	Lime		
3483	3515	Lime	3500-00	
3515	3527	Lime		
3527	3565	Lime		
3565	3615	Lime		
3615	3660	Congl.		
3660	3715	T.D.		

RECEIVED
STATE OF KANSAS
COMMISSIONER OF GEOLOGY

CASING LEFT IN HOLE AFTER COMPLETION
Ran 220.16' (7 joints.) 8-5/8" Casing.

STATE OF KANSAS, COUNTY OF SEDGWICK)ss.

The undersigned certifies that to the best of his knowledge and belief, the above facts are true and correct.

C-G DRILLING CO., Inc.

By *R.A. Cook*
President

Subscribed and sworn to before me this 2nd day of April, 1951

My commission expires:
August 11, 1954

Almeda Lowe
Notary Public

PLUGGING
FILE SEC 26 T 10 R 18 W
BOOK PAGE 20 LINE 48