


STATE OF KANSAS
STATE CORPORATION COMMISSION

Give all information completely
Make Required Affidavit
Mail or Deliver Report to:
Conservation Division
State Corporation Commission
211 No. Broadway
Wichita, Kansas

WELL PLUGGING RECORD

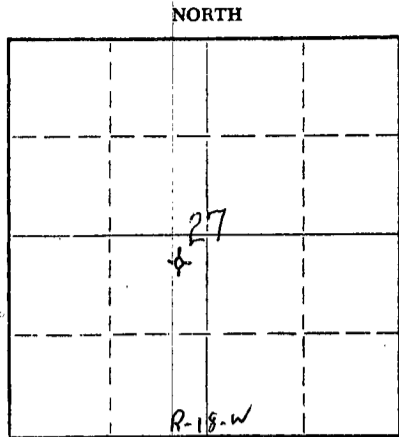

Locate well correctly on above
Section Plat

Rooks

County. Sec. 27 Twp. 10S Rge. 18W (E) W (W)

Location as "NE/CNWxSWx" or footage from lines. NE - NE - SW
Lease Owner Davis Bros.
Lease Name Eilers Well No. A-I
Office Address Tulsa Oklahoma
Character of Well (completed as Oil, Gas or Dry Hole)
Date well completed 19
Application for plugging filed 19
Application for plugging approved 19
Plugging commenced Feb. 19 19 62
Plugging completed March 6 19 62
Reason for abandonment of well or producing formation

If a producing well is abandoned, date of last production 19
Was permission obtained from the Conservation Division or its agents before plugging was commenced? Yes

Name of Conservation Agent who supervised plugging of this well Elden Petty
Producing formation Depth to top Bottom Total Depth of Well 3686 Feet
Show depth and thickness of all water, oil and gas formations.

OIL, GAS OR WATER RECORDS

CASING RECORD

FORMATION	CONTENT	FROM	TO	SIZE	PUT IN	PULLED OUT
K. C. Formation	Water	3350	3547	4 1/2 OD	3683	877

Describe in detail the manner in which the well was plugged, indicating where the mud fluid was placed and the method or methods used in introducing it into the hole. If cement or other plugs were used, state the character of same and depth placed, from surface feet to surface feet for each plug set.

4 1/2 set at 3683, Plug back to 3525, Sanded up to 3340, Dump 4 sacks of cement on bottom. Pulled pipe up to 550 feet, Circ. with mud and pump 20 sacks cement to 550 feet. Pulled pipe up to 170 feet pump 20 sacks cement to 170 feet. Pulled pipe out put 10 sacks of cement on top. Well completed

RECEIVED
STATE CORPORATION COMMISSION
3-29-62
MAR 29 1962
CONSERVATION DIVISION
Wichita, Kansas

(If additional description is necessary, use BACK of this sheet)
Name of Plugging Contractor Barnes & Sons Pipe Pulling Co.
Address Russell, Kansas

STATE OF OKLAHOMA, COUNTY OF Tulsa, ss.

(employee of owner) or (owner or operator) of the above-described well, being first duly sworn on oath, says: That I have knowledge of the facts, statements, and matters herein contained and the log of the above-described well as filed and that the same are true and correct. So help me God.

(Signature) Davis Bros. By R.H. Henderson, Mgr. of Prod'n
510-MS Farlan Bldg. Tulsa - Okla
(Address)

SUBSCRIBED AND SWORN to before me this 28th day of March 19 62

My Commission Expires Feb. 28, 1965

Betty Corbush
Notary Public.

