


15-163-20917-0000

STATE OF KANSAS
STATE CORPORATION COMMISSION

WELL PLUGGING RECORD

Give All Information Completely.
Make Required Affidavit
Mail or Deliver Report to
Conservation Division
State Corporation Comm.
245 North Water
Wichita, KS 67202

Rooks County, Sec. 28 Twp. 10 Rge. 18 ~~NE~~/W
Location as "NE/CNW $\frac{1}{4}$ SW $\frac{1}{4}$ " or footage from lines _____
NE NE NW
Lease Owner Price Exploration Co.
Lease Name PEC Bates Well No. 1
Office Address 814 Mayo Bldg., Tulsa, Oklahoma 74103
Character of Well (Completed as Oil, Gas or Dry Hole) _____

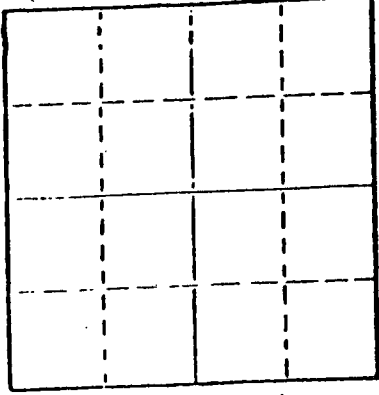

Locate well correctly on above
Section Plat

Date Well completed May 24 1979
Application for plugging filed May 24 1979
Application for plugging approved May 24 1979
Plugging commenced May 24 1979
Plugging completed May 24 1979
Reason for abandonment of well or producing formation _____
dry hole

If a producing well is abandoned, date of last production 19 _____

Was permission obtained from the Conservation Division or its agents before plugging was commenced? Yes _____

Name of Conservation Agent who supervised plugging of this well Leo Massey
Producing formation _____ Depth to top _____ Bottom _____ Total Depth of Well 3746
Show depth and thickness of all water, oil and gas formations.

OIL, GAS OR WATER RECORDS

CASING RECORD

FORMATION	CONTENT	FROM	TO	SIZE	PUT IN	PULLED OUT
				8 5/8	255'	

Describe in detail the manner in which the well was plugged, indicating where the mud fluid was placed and the method or methods used in introducing it into the hold. If cement or other plugs were used, state the character of same and depth placed, from _____ feet to _____ feet for each plug set.

1st plug 675' w/60 sx.
2nd plug 240' w/25 sx.
3rd plug 40' w/10 sx.
5 sx in rathole

RECEIVED
STATE CORPORATION COMMISSION
5-31-79
MAY 31 1979

(If additional description is necessary, use BACK of this sheet.)
Name of Plugging Contractor Woodman & Iannitti Drilling Co. Conservation Division
Wichita, Kansas


STATE OF KANSAS COUNTY OF SEDGWICK, ss.
K. T. Woodman (employee of owner) or (owner or operator
of the above-described well, being first duly sworn on oath, says: That I have knowledge of the facts, statements, and matters herein contained and the log of the above-described well as filed and that the same are true and correct. So help me God.

(Signature) K. T. Woodman
1008 Douglas Bldg. 104 So. Broadway
(Address)

SUBSCRIBED AND SWORN TO before me this 30th day of May, 19 79

Justina Chamberlain
Justina Chamberlain Notary Public.

My commission expires Feb. 11, 1980

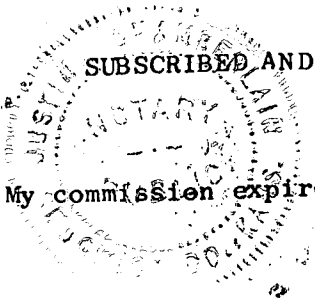

WOODMAN & IANNITTI DRILLING COMPANY

Rotary Drilling Contractors

1008 DOUGLAS BUILDING
104 S. BROADWAY
WICHITA, KANSAS 67202

May 30, 1979

Company;	Price Exploration Co.
Farm;	PEC #1 Bates
Location;	NE NE NW
Section;	28-10S-18W
County;	Rooks
Contractor;	Woodman & Iannitti Drilling Co.
Total Depth;	3746
Comm;	May 17, 1979
Compl;	May 24, 1979
Casing;	8 5/8 @ 255' w/160 sx.
Production;	D & A

Figures Indicate Bottom Of Formations:

30	Shale & post rock
40	Post rock
257	Shale
530	Sand & shale
650	Shale
900	Redbed & shale
1135	Dakota sand
1419	Shale & sand streaks
1440	Anhy
1463	Anhy
1915	Shale & sand
2245	Shale
2720	Shale & lime
3016	Lime & shale
3465	Lime & shale
3570	Lime & shale
3680	Lime & shale
3704	Lime & shale & chert
3746	Arbuckle

RECEIVED
STATE CORPORATION COMMISSION
MAY 31 1979
CONSERVATION DIVISION
Wichita, Kansas

I certify the above to be a true and correct copy of the drillers log to the best of my knowledge and belief.

Woodman & Iannitti Drilling Co.
K. T. Woodman
K. T. Woodman