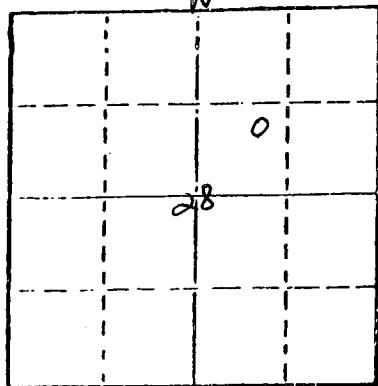


STATE OF KANSAS
STATE CORPORATION COMMISSION

Give All Information Completely
Make Required Affidavit
Mail or Deliver Report to
Conservation Division
State Corporation Comm.
245 North Water
Wichita, KS 67202

Locate well correctly on above
Section Plat

WELL PLUGGING RECORD

Rooks County. Sec. 28 Twp. 10S Rge. 18 E/W
Location as "NE/CNW,SW1" or footage from lines _____
NE SW NE
Lease Owner John P. Jennings Oil Co.
Lease Name Henn Well No. 1
Office Address 200 E. First, Suite 309, Wichita, Ks. 67202
Character of Well (Completed as Oil, Gas or Dry Hole) _____
Dry Hole
Date Well completed July 23 1978
Application for plugging filed (verbally) July 23 1978
Application for plugging approved (verbally) July 23 1978
Plugging commenced July 23 1978
Plugging completed July 23 1978
Reason for abandonment of well or producing formation _____
No commercial quantity of oil or gas encountered
If a producing well is abandoned, date of last production 19

Was permission obtained from the Conservation Division or
its agents before plugging was commenced? Yes

Name of Conservation Agent who supervised plugging of this well Leo Massey
Producing formation _____ Depth to top _____ Bottom _____ Total Depth of Well 3670
Show depth and thickness of all water, oil and gas formations.

OIL, GAS OR WATER RECORDS

CASING RECORD

FORMATION	CONTENT	FROM	TO	SIZE	PUT IN	PULLED OUT

Describe in detail the manner in which the well was plugged, indicating where the mud fluid was placed and the method or methods used in introducing it into the hole. If cement or other plugs were used, state the character of same and depth placed, from _____ feet to _____ feet for each plug set.

Set 1st plug at 600' with 70 sacks
2nd plug at 240' with 20 sacks
3rd plug at 40' with 10 sacks
Cemented with 50/50 posmix, 6% gel

RECEIVED
STATE CORPORATION COMMISSION
AUG 01 1978
CONSERVATION DIVISION
Wichita, Kansas

(If additional description is necessary, use BACK of this sheet)

Name of Plugging Contractor Abercrombie Drilling, Inc.

STATE OF KANSAS COUNTY OF SEDGWICK, ss.
Jack L. Partridge, Ass't. Sec.-Treas. (employee of owner) or (owner or operator) of the above-described well, being first duly sworn on oath, says: That I have knowledge of the facts, statements, and matters herein contained and the log of the above-described well as filed and that the same are true and correct. So help me God.

(Signature)

Jack L. Partridge
801 Union Center, Wichita, Kansas 67202

(Address)

31st day of July, 1978

Sandra Richman
Sandra Richman

Notary Public.

NOTARY

PUBLIC

My commission expires July 21, 1979

OPERATOR: John P. Jennings Oil Co.
 CONTRACTOR: Abercrombie Drilling, Inc.
 WELL NAME: Henn #1
 LOCATION: NE SW NE Section 28-10S-18W
 Rooks County, Kansas
 SPUD DATE: July 14, 1978
 COMPLETION DATE: July 23, 1978

0	261	Rock & shale
261	1420	Shale & sand
1420	1455	Anhydrite
1455	1785	Sand & shale
1785	3082	Shale & lime
3082	3339	Lime
3339	3380	Lime & shale
3380	3472	Shale & lime
3472	3480	Lime & shale
3480	3555	Lime
3555	3654	Shale & lime
3654	3670	Lime
	3670	Rotary Total Depth

Spud hole at 1:00 p.m., July 14, 1978. Drilled 261' of 12 $\frac{1}{4}$ " hole. Ran 6 jolts of 8-5/8" (28#) surface casing. Set at 256.13' with 165 sacks common cement, 3% CaCl, 2% gel. Cement did circulate. Plug was down at 8:00 p.m., July 14, 1978.

T.D. 3670'. Set first plug at 600' with 70 sacks, second plug at 240' with 20 sacks, top plug at 40' with 10 sacks. Cemented with 50/50 posmix, 6% Gel. Plug was down at 6:00 a.m., July 23, 1978. State Plugger, Leo Massey.

SAMPLE TOPS:

Anhydrite 1420' (+ 661)
 B/Anhydrite 1455' (+ 626)

RECEIVED
 STATE CORPORATION COMMISSION
 AUG 01 1978
 CONSERVATION DIVISION
 Wichita, Kansas

STATE OF KANSAS)
) ss
 COUNTY OF SEDGWICK)

Jack L. Partridge, Assistant Secretary-Treasurer of Abercrombie Drilling, Inc., does hereby state that the above and foregoing is a true and correct copy of the log of the Henn #1, NE SW NE Section 28-10S-18W, Rooks County, Kansas.

ABERCROMBIE DRILLING, INC.

BY Jack L. Partridge
 Jack L. Partridge,
 Assistant Secretary-Treasurer

Subscribed and sworn to before me, a Notary Public, in and for the county and state aforesaid, as of this 31st day of July, 1978.

Sandra Richman
 Sandra Richman, Notary Public

NOTARY
 PUBLIC
 My commission expires July 21, 1979.