

Notice: Fill out COMPLETELY and return to Conservation Division at the address below within 60 days from plugging date.

KANSAS CORPORATION COMMISSION
OIL & GAS CONSERVATION DIVISION
WELL PLUGGING RECORD
K.A.R. 82-3-117

Form CP-4
March 2009
Type or Print on this Form
Form must be Signed
All blanks must be Filled

OPERATOR: License #: 34002
Name: Kinder Morgan Interstate Gas Transmission LLC
Address 1: 145 N. Country Club Drive
Address 2: _____
City: Colby State: KS Zip: 67701 + _____
Contact Person: Mark Bredemeier
Phone: (785) 462-6815 ext. 223 - Cell - 785-443-1252
Type of Well: (Check one) Oil Well Gas Well OG D&A Cathodic
 Water Supply Well Other: _____ SWD Permit #: _____
 ENHR Permit #: _____ Gas Storage Permit #: _____
Is ACO-1 filed? Yes No If not, is well log attached? Yes No
Producing Formation(s): List All (if needed attach another sheet)
NA Depth to Top: _____ Bottom: _____ T.D. _____
NA Depth to Top: _____ Bottom: _____ T.D. _____
NA Depth to Top: _____ Bottom: _____ T.D. _____

API No. 15 - 101-22153-00-00
Spot Description: _____
SW NW SW NW Sec. 23 Twp. 16 S. R. 30 East West
1,705 Feet from North / South Line of Section
85 Feet from East / West Line of Section
Footages Calculated from Nearest Outside Section Corner:
 NE NW SE SW
County: Lane
Lease Name: Healy Valve Setting ^{unit} Well #: 1
Date Well Completed: 06-11-09
The plugging proposal was approved on: 02-05-09 (Date)
by: Rick - KCC Office - Wichita (KCC District Agent's Name)
Plugging Commenced: 06-11-09
Plugging Completed: 06-11-09

Show depth and thickness of all water, oil and gas formations.

Oil, Gas or Water Records		Casing Record (Surface, Conductor & Production)			
Formation	Content	Casing	Size	Setting Depth	Pulled Out
		Surface - Sch. 40 PVC	10"	20'	0'

RECEIVED
JUL 06 2009
KCC WICHITA

Describe in detail the manner in which the well is plugged, indicating where the mud fluid was placed and the method or methods used in introducing it into the hole. If cement or other plugs were used, state the character of same depth placed from (bottom), to (top) for each plug set.

Cathodic Anodes Were Installed On 10' Center Into The Cathodic Borehole From Approx. 40' To Approx. 290' And Carbo Coke 60 Was Pumped Around The Anode String. After Anode Installation Bentonite Chips Were Poured Into Borehole From Carbo Coke Level To 3' Below Ground Level. Total Of 26 - 50# Bags Of Bentonite Chips Were Used To Plug Cathodic Borehole From Top Of Carbo Coke Level To 3' Below Ground Level.

Plugging Contractor License #: 34002 Name: Kinder Morgan Interstate Gas Transmission LLC
Address 1: 145 N. Country Club Drive Address 2: _____
City: Colby State: KS Zip: 67701 + _____
Phone: (785) 462-6815 ext. 223 - Cell - 785-443-1252
Name of Party Responsible for Plugging Fees: Kinder Morgan Interstate Gas Transmission LLC
State of Kansas County, Lane, ss.
Mark Bredemeier Employee of Operator or Operator on above-described well.
(Print Name)

being first duly sworn on oath, says: That I have knowledge of the facts statements, and matters herein contained, and the log of the above-described well is as filed, and the same are true and correct, so help me God.


Signature: Mark Bredemeier - Conservation Technician

Handwritten initials/signature

**HEALY VALVE SETTING UNIT
2009 Groundbed Installation
API No. 15-101-22153-00-00**




NOT DRAWN TO SCALE

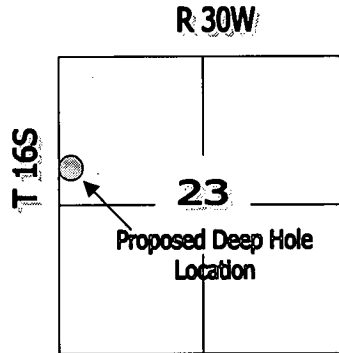

Lane Co. KS.

WELL BORE DIAGRAM

Top Of Borehole And Casing
3'-4' Below Ground Level

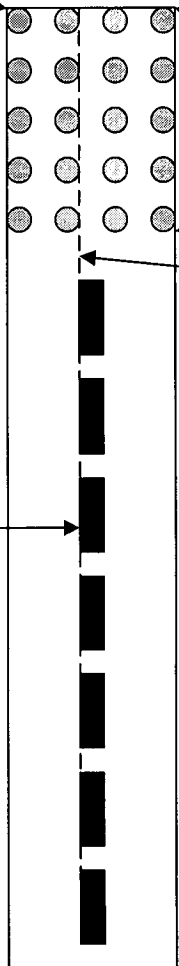

20 - 50# Bags Bentonite Chips Used To Plug
Well From Top Of Coke Column
To Top Of Casing - Approx. 40'

Cables From Anodes

25 - 4"x80" Graphite Anodes
Evenly Spaced In Column

RECEIVED
JUL 06 2009
KCC WICHITA