

Notice: Fill out COMPLETELY and return to Conservation Division at the address below within 60 days from plugging date

KANSAS CORPORATION COMMISSION OIL & GAS CONSERVATION DIVISION WELL PLUGGING RECORD K.A.R. 82-3-117

KANSAS CORPORATION COMMISSION

Form CP-4 December 2003

Type or Print on this Form Form must be Signed All blanks must be Filled

JUL 30 2009

RECEIVED

Lease Operator: Presco Western, LLC
Address: 5665 FLATIRON PARKWAY BOULDER CO 80301
Phone: 303-305-1163 Operator License #: 32309
Type of Well: Oil Docket #:
The plugging proposal was approved on: 6/10/2009
by: Steve Durant (KCC District Agent's Name)
Is ACO-1 filed? Yes No
Producing Formation(s): List All (If needed attach another sheet)

API Number: 15- 067-21066-0000
Lease Name: W.B. Scherling
Well Number: 1-29 29-1
Spot Location (QQQQ): C - SW - NW - NW
4,290 Feet from North Section Line
4,950 Feet from East Section Line
Sec. 29 Twp. 29 S. R. 38 East West
County: Grant
Date Well Completed: 7/16/2009
Plugging Commenced: 7/17/2009
Plugging Completed: 7/17/2009

Show depth and thickness of all water, oil and gas formations.

Table with columns: Oil, Gas or Water Records (Formation, Content) and Casing Record (Surface Conductor & Production) (From, To, Size, Put in, Pulled out)

Describe in detail the manner in which the well was plugged, indicating where the mud fluid was placed and the method or methods used in introducing it into the hole.

Plug 1: CIBP @ 5,620' w/ 2 SKS cmt. Plug 2: 20 SKS 60/40 POZ cmt @ 2,902'. Plug 3: Shot squeeze holes @ 1,860', circulated cmt to surface w/ 410 sks cmt.

Name of Plugging Contractor: Basic Energy Services, L.P. License #: 34069

Address: P.O. Box 129, Liberal, KS 67905

Name of Party Responsible for Plugging Fees: Presco Western, LLC

State of Colorado County, Boulder, ss.

Keli Kowalski (Employee of Operator) or (Operator) on above-described well, being first duly sworn on oath, says: That I have knowledge of the facts statements, and matters herein contained, and the log of the above-described well as filed and the same are true and correct, so help me God.

(Signature) Keli Kowalski

(Address) 5665 Flatiron Parkway, Boulder, CO 80301

SUBSCRIBED and SWORN TO before me this 29th day of July, 2009


Judra Blackburn My Commission Expires: 01/29/2013

WB SCHERLING 29-1
15-067-21066

KANSAS CORPORATION COMMISSION

JUL 30 2009
RECEIVED

PLUGGING COMMENCED:
7/16/09
PLUGGING COMPLETED:
7/17/09
PLUGGING APPROVED:
VERBALLY BY STEVE DURRANT
(KCC) ON 6/10/09
PLUGGING CONTRACTOR:
BASIC ENERGY
COMPANY REP:
CLINT ANDREWS

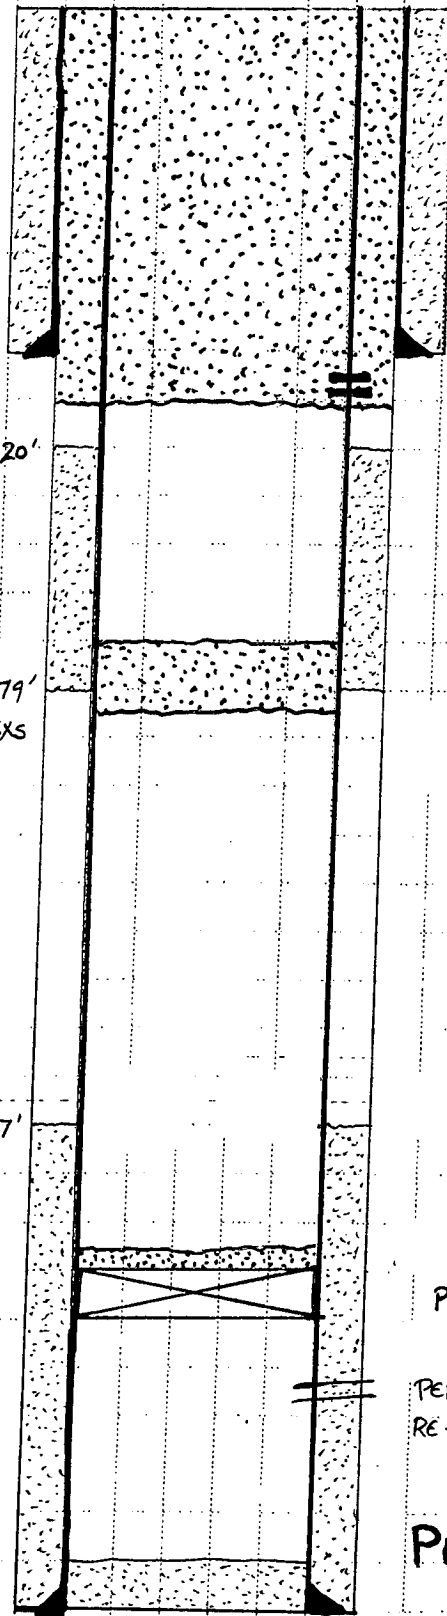

SURFACE CSG

8 5/8" 24 # K-55 @ 1,831'
CMT'D W/ 815 SXS

PLUG #3 - SHOT SQUEEZE HOLES @ 1,860';
CIRCULATED CMT TO SURFACE, CMT'D
W/ 410 SXS CMT

PLUG #2 - 20 SXS 60/40 POZ CMT @ 2,902'

DV TOOL @ 2,879'
CMT'D W/ 240 SXS

PLUG #1 - CIBP @ 5,620' W/ 2 SXS CMT

PERFS 5,667' - 5,674' (ST. LOUIS)
RE-PERF'D 5,667' - 5,671' (ST. LOUIS)

PRODUCTION CSG

5 1/2" 15.5 # K-55 @ 5,918'
CMT'D W/ 390 SXS