

Notice: Fill out COMPLETELY and return to Conservation Division at the address below within 60 days from plugging date

KANSAS CORPORATION COMMISSION OIL & GAS CONSERVATION DIVISION WELL PLUGGING RECORD K.A.R. 82-3-117

Form CP-4 December 2003 Type or Print on this Form Form must be Signed All blanks must be Filled

JUL 30 2009

RECEIVED

Lease Operator: Presco Western, LLC
Address: 5665 FLATIRON PARKWAY BOULDER CO 80301
Phone: 303-305-1163 Operator License #: 32309
Type of Well: Oil Docket #:
The plugging proposal was approved on: 6/10/2009
by: Steve Durant (KCC District Agent's Name)
Is ACO-1 filed? Yes No
Producing Formation(s): List All (If needed attach another sheet)

API Number: 15- 187-20971 - 0000
Lease Name: Western Feed Yard
Well Number: 2-1433
Spot Location (QQQQ): C - SE - SE - SW
442 Feet from North Section Line
2,299 Feet from East Section Line
Sec. 33 Twp. 28 S. R. 40 East West
County: Stanton
Date Well Completed: 7/6/2009
Plugging Commenced: 7/7/2009
Plugging Completed: 7/7/2009

Show depth and thickness of all water, oil and gas formations.

Table with 7 columns: Oil, Gas or Water Records (Formation, Content) and Casing Record (Surface Conductor & Production) (From, To, Size, Put in, Pulled out)

Describe in detail the manner in which the well was plugged, indicating where the mud fluid was placed and the method or methods used in introducing it into the hole.

Plug 1: CIBP @ 5,370' w/ 2 SKS cmt. Plug 2: Shoot squeeze holes @ 1,750-1,751' and pump 35 bbls to establish circulation. Pump 400 SKS 60/40 POZ w/ 4% gel mixed @ 13.5 PPG. Circulate 70 SKS to pit. Ok'd by Ken Jehlick.

Name of Plugging Contractor: Basic Energy Services, L.P. License #: 34069

Address: P.O. Box 129, Liberal, KS 67905

Name of Party Responsible for Plugging Fees: Presco Western, LLC

State of Colorado County, Boulder, ss.

Keli Kowalski (Employee of Operator) or (Operator) on above-described well, being first duly sworn on oath, says: That I have knowledge of the facts statements, and matters herein contained, and the log of the above-described well as filed and the same are true and correct, so help me God.

(Signature) Keli Kowalski

(Address) 5665 Flatiron Parkway, Boulder, CO 80301

SUBSCRIBED and SWORN TO before me this 29th day of July, 2009


Judith Blackburn Notary Public My Commission Expires: 01/29/2013

JUL 30 2009

STANTON COUNTY RECEIVED

WESTERN FEED YARD 2-1433
15-187-20971

PLUGGING COMMENCED:
7/6/09
PLUGGING COMPLETED:
7/7/09
PLUGGING APPROVED:
VERBALLY BY STEVE
BARRANT (KCC) 6/10/09
PLUGGING CONTRACTOR:
BASIC ENERGY
COMPANY REP:
STEVE RIDENOUR
KCC REP:
KEN JEHLICK

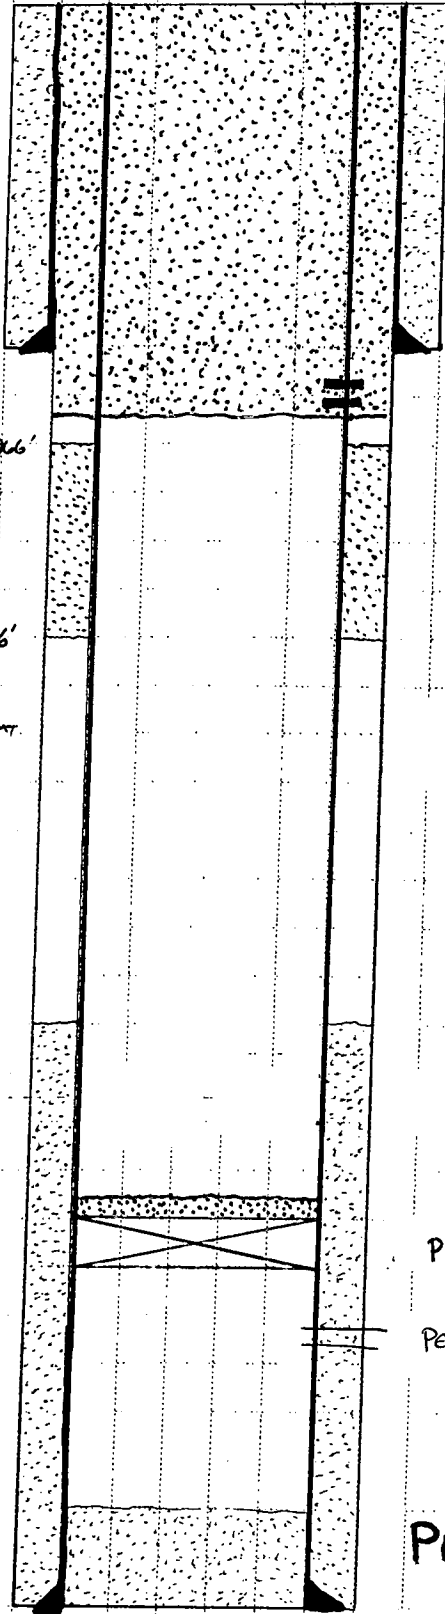

SURFACE CSG

8 5/8" @ 1,727'

PLUG #2 - SHOT SQUEEZE HOLES @ 1,750'
CIRCULATED CMT TO SURFACE,
CMT'D W/ 330 SX5 CMT (60/40 P02)
(PUMPED 400 SX5 CMT, CIRCULATED
TO SX5 TO PIT)

DV TOOL
@ 3076'

HAVE RATTY CMT
UP TO 1510'

PLUG #1 - CIBP @ 5,376' w/ 2 SX5 CMT

PERFS 5,415' - 5,429' (MORROW)

PRODUCTION CSG

5 1/2" @ 5,509'