


WELL PLUGGING RECORD

Give All Information Completely
Make Required Affidavit
Mail or Deliver Report to:
Conservation Division
State Corporation Commission
211 No. Broadway
Wichita, Kansas

NORTH

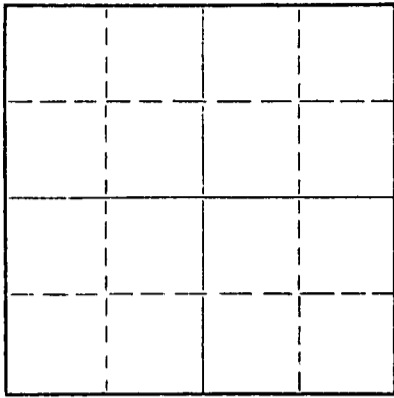

Locate well correctly on above
Section Plat

Rooks County. Sec. 3 Twp. 10S Rge. 19W(E) (W)
Location as "NE/CNW/SW" or footage from lines SE NW NE
Lease Owner Leben Drilling, Inc.
Lease Name Sparks Well No. 1
Office Address 905 Central Building
Character of Well (completed as Oil, Gas or Dry Hole) Dry Hole
Date well completed July 11, 1957 19
Application for plugging filed July 11, 1957 19
Application for plugging approved July 11, 1957 19
Plugging commenced July 11, 1957 19
Plugging completed July 11, 1957 19
Reason for abandonment of well or producing formation Dry Hole

If a producing well is abandoned, date of last production - 19
Was permission obtained from the Conservation Division or its agents before plugging was commenced? M Yes

Name of Conservation Agent who supervised plugging of this well Eldon Petty
Producing formation _____ Depth to top _____ Bottom _____ Total Depth of Well _____ Feet
Show depth and thickness of all water, oil and gas formations.

OIL, GAS OR WATER RECORDS

CASING RECORD

FORMATION	CONTENT	FROM	TO	SIZE	PUT IN	PULLED OUT
				6 5/8"	243'	None

Describe in detail the manner in which the well was plugged, indicating where the mud fluid was placed and the method or methods used in introducing it into the hole. If cement or other plugs were used, state the character of same and depth placed, from _____ feet to _____ feet for each plug set.

1st Plug @ 550' w/25 sacks cement.
2nd Plug @ 40' w/10 sacks cement.

(If additional description is necessary, use BACK of this sheet)

Name of Plugging Contractor Leben Drilling, Inc.
Address 905 Central Building, Wichita, Kansas

STATE OF Kansas, COUNTY OF Sedgwick, ss.
Frank Hamlin (employee of owner) or (owner or operator) of the above-described well, being first duly sworn on oath, says: That I have knowledge of the facts, statements, and matters herein contained and the log of the above-described well as filed and that the same are true and correct. So help me God.

(Signature) Frank Hamlin
905 Central Bldg., Wichita, Kansas (Address)

SUBSCRIBED AND SWORN TO before me this 18th day of July, 1957

My commission expires June 17, 1961

Ruth H. Benjamin
Ruth H. Benjamin Notary Public.

STATE CORPORATION COMMISSION
7-19-57
JUL 19 1957
CONSERVATION DIVISION

PLUGGING
FILE SEC 3 T10 19W
BOOK PAGE 27 L1 E13

15-103-10-19W

WELL LOG

COMPANY: LEBEN DRILLING, INC.
 CONTRACTOR: LEBEN DRILLING, INC.
 FARM: SPARKS #1
 LOCATION: SE NW NE Sec. 3-10S-19W
 ROCKS COUNTY, KANSAS
 COMMENCED: JUNE 22, 1957
 COMPLETED: JULY 11, 1957

0	625	Shale		
625	825	Sand & Shale	<u>TOPS:</u>	
825	985	Shale & Sand	Topoka	3104
985	1250	Sand & Shale	Heebner	3314
1250	1505	Shale & Redbed	Toronto	3335
1505	1515	Redbed	Lansing-KC	3354
1515	1550	Anhydrite	Base KC	3536
1550	1735	Shale & Shells	Arbuckle	3617
1735	1920	Shale & Shells		
1920	2115	Shale & Lime		
2115	2315	Shale & Lime		
2315	2610	Shale & Lime		
2610	2845	Shale & Lime		
2845	3190	Shale & Lime		
3190	3245	Shale & Lime		
3245	3310	Cherty Lime & Shale		
3310	3352	Lime & Shale		
3352	3395	Lime		
3395	3434	Lime		
3434	3520	Lime		
3520	3605	Lime		
3605	3628	Conglomerate		
3628	3665	Drillings		
	3665	<u>Rotary Total Depth - D & A</u>		

Set 6 5/8" surface casing at 216' with 150 sacks cement & 3 sacks CaCl.

I, Frank Hamlin, do hereby certify that the above and foregoing is a true and correct copy of the log of the Sparks #1, SE NW NE of Section 3, Township 10 South, Range 19 West, Rooks County, Kansas, as reflected by the files of Leben Drilling, Inc.

LEBEN DRILLING, INC.

By: Frank Hamlin
Frank Hamlin

STATE OF KANSAS }
COUNTY OF SEDGWICK } SS

Subscribed and sworn to before, a Notary Public, in and for Sedgwick County, Kansas, this 18th day of July, 1957.

Euth N. Benjamin
Euth N. Benjamin Notary Public

My commission expires:
June 17, 1961

PLUGGING
SEC. 3 T10 R19W
PAGE 27 OF 13