


WELL PLUGGING RECORD

Give All Information Completely
Make Required Affidavit
Mail or Deliver Report to:
Conservation Division
State Corporation Commission
800 Bittling Building
Wichita, Kansas

NORTH

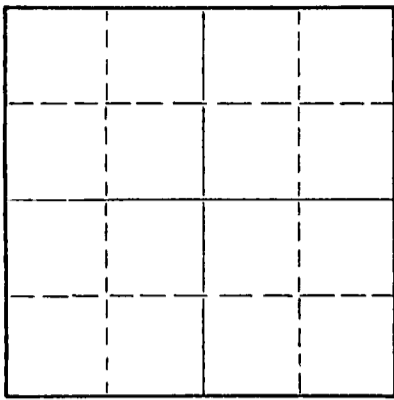

Locate well correctly on above
Section Plat

Rooks _____ County. Sec. 3 Twp. 10 Rge. (E) 19 (W) _____
Location as "NE/CNW/SE/SW" or footage from lines NW SE SW
Lease Owner Strata Drilling, Inc.
Lease Name Sparks Well No. 1
Office Address Corbide Bldg., Great Bend, Kansas
Character of Well (completed as Oil, Gas or Dry Hole) Dry Hole
Date well completed _____ 7/2 19 56
Application for plugging filed _____ 7/2 19 56
Application for plugging approved _____ 7/3 19 56
Plugging commenced _____ 7/3 19 56
Plugging completed _____ 7/3 19 56
Reason for abandonment of well or producing formation Dry Hole

If a producing well is abandoned, date of last production _____ 19 _____
Was permission obtained from the Conservation Division or its agents before plugging was commenced? Yes

Name of Conservation Agent who supervised plugging of this well Elvin Petty, Hays, Kansas
Producing formation _____ Depth to top _____ Bottom _____ Total Depth of Well 3730 Feet
Show depth and thickness of all water, oil and gas formations.

OIL, GAS OR WATER RECORDS

CASING RECORD

FORMATION	CONTENT	FROM	TO	SIZE	PUT IN	PULLED OUT
				5/8"	2071	

Describe in detail the manner in which the well was plugged, indicating where the mud fluid was placed and the method or methods used in introducing it into the hole. If cement or other plugs were used, state the character of same and depth placed, from _____ feet to _____ feet for each plug set.

Hole filled with heavy mud to 200'. First plug set with 15 sacks of cement. Hole filled with heavy mud to 40'. Second plug set with 10 sacks of cement.

(If additional description is necessary, use BACK of this sheet)

Name of Plugging Contractor Strata Drilling, Inc.
Address Corbide Bldg., Great Bend, Kansas

STATE OF Kansas, COUNTY OF Barton, ss.
Charles W. Steincamp (employee of owner) or (owner or operator) of the above-described well, being first duly sworn on oath, says: That I have knowledge of the facts, statements, and matters herein contained and the log of the above-described well as filed and that the same are true and correct. So help me God.

(Signature) Charles W. Steincamp
Corbide Bldg., Great Bend, Kansas (Address)

SUBSCRIBED AND SWORN to before me this 5th day of July, 19 56
Mary C. Johnson Notary Public.

My commission expires 11/21/59

PLUGGING
FILE SEC. 3 T. 10 R. 19w
BOOK PAGE 77 LINE 19

7-6-56

15-163-00991-0000

W. SPARKS

Casing Record: 20 7/8" of 8-5/8"

COMPANY: Strata Drilling, Inc. Description: NW SE NW 3-10S-19W Rocks County, Kansas

CONTRACTOR: Strata Drilling, Inc.

COMMENCED: June 24, 1956

COMPLETED: July 3, 1956 Elevation: 2170' DF 2168' GL

DRILL HOLE

Formation	From	To	Remarks
Surface Soil	0	199	8 5/8" Casing cemented with 140 sacks cement, 2% Calcium Chloride.
Shale	199	520	
Shale and Shale	520	1070	
Dakota Sand	1070	1275	
Shale and Shale	1275	1555	
Anhydrite	1555	1570	
Shale	1570	1880	
Shale and Lime	1880	2670	
Shale	2670	2955	
Shale and Lime	2955	3407	
Lime	3407	3435	
Lime and Shale	3435	3520	
Lime	3520	3555	
Shale and Lime	3555	3585	Plugged hole with 15 sacks cement and plug @ 200'; Plug and 10 sacks cement @ 40'.
Lime	3585	3623	
Conglomerate and Lime	3623	3650	
Shale and Lime	3650	3680	
Conglomerate and Lime	3680	3725	Total Depth

Top Topoka 3116'

Heebrier 3326'

Toronto 3347'

Lensing 3366'

Arbuckle 3683'

Drill Stem Test #1: 3358-3462.
Open 1 hour; shut in 20 min.
Recovered 1965' salt water. BHP 1195#.

Drill Stem Test #2: 3566-3590.
Open 30 min.; shut in 20 min.
Recovered 35' mud. BHP 65#.

Drill Stem Test #3: 3591-3628.
Open 30 min.; shut in 20 min.
Recovered 50' mud. BHP 760#.

I certify that this is a true and correct copy of the above log to the best of my knowledge.

STRATA DRILLING, INC.

Charles W. Steincamp
 CHARLES W. STEINCAMP President

Subscribed and sworn to before me this 5th day of July, 1956

PLUGGING
 FILE SEC 3 T 10 R 14
 BOOK PAGE 27 LINE 14

Mary O. Johnson
 Notary Public

My Commission Expires: November 21, 1959