


STATE OF KANSAS  
STATE CORPORATION COMMISSION

WELL PLUGGING RECORD

Give All Information Completely  
Make Required Affidavit  
Mail or Deliver Report to:  
Conservation Division  
State Corporation Commission  
800 Biting Building  
Wichita, Kansas

Rocks \_\_\_\_\_ County. Sec. 4 Twp. 10S Rge. 19W (E) \_\_\_\_\_ (W)  
Location as "NE/CNW/SE/SW" or footage from lines SE NW SW  
Lease Owner L. B. Stableford  
Lease Name Ondrasek Well No. 4  
Office Address 1003 Central Building  
Character of Well (completed as Oil, Gas or Dry Hole) Dry hole  
Date well completed December 22 1953  
Application for plugging filed December 22 1953  
Application for plugging approved December 22 1953  
Plugging commenced 8:00 a.m., December 22 1953  
Plugging completed 11:45 a.m., December 22 1953  
Reason for abandonment of well or producing formation \_\_\_\_\_  
Commercial quantity of oil not found  
If a producing well is abandoned, date of last production \_\_\_\_\_ 19\_\_\_\_  
Was permission obtained from the Conservation Division or its agents before plugging was commenced? Yes

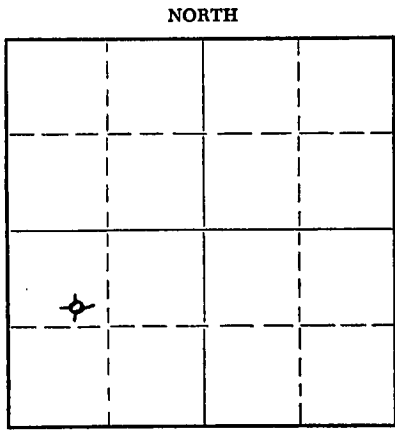

Locate well correctly on above  
Section Plat

Name of Conservation Agent who supervised plugging of this well Eldon Petty  
Producing formation \_\_\_\_\_ Depth to top \_\_\_\_\_ Bottom \_\_\_\_\_ Total Depth of Well 3761' Feet  
Show depth and thickness of all water, oil and gas formations.

OIL, GAS OR WATER RECORDS

CASING RECORD

FORMATION	CONTENT	FROM	TO	SIZE	PUT IN	PULLED OUT
				8 5/8"	185'	

Describe in detail the manner in which the well was plugged, indicating where the mud fluid was placed and the method or methods used in introducing it into the hole. If cement or other plugs were used, state the character of same and depth placed, from \_\_\_\_\_ feet to \_\_\_\_\_ feet for each plug set.

Set plug @ 180' w/15 sacks cement  
Set plug @ 40' w/10 sacks cement

12-30-53

(If additional description is necessary, use BACK of this sheet)

Name of Plugging Contractor K & E DRILLING, INC.  
Address 1006 Central Building, Wichita, Kansas

STATE OF Kansas, COUNTY OF Sedgwick, ss.  
Clinton Engstrand, agent for \_\_\_\_\_ (employee of owner) or (owner or operator) of the above-described well, being first duly sworn on oath, says: That I have knowledge of the facts, statements, and matters herein contained and the log of the above-described well as filed and that the same are true and correct. So help me God.

(Signature) [Signature]  
1006 Central Building, Wichita, Kansas  
(Address)

SUBSCRIBED AND SWORN to before me this 29 day of December, 19 53

[Signature]  
Notary Public.

My commission expires October 29, 1955

24-7968-5 3-53-20M  
**PLUGGING**  
FILE SEC 4 T 10 R 19W  
BOOK PAGE 4 LINE 13

L. B. STABLEFORD  
NO. 4 ONDRASEK

SE NW SW Sec. 4-10S-19W  
Rooks County, Kansas

Casing  
8 5/8" Set @ 185'

Cement  
125 Sacks

Comm: 12-11-53  
Comp: 12-22-53  
Total Depth: 3761'

<u>FORMATION</u>	<u>DEPTH</u>
Sand and shale	0 - 185
Shale	185 - 225
Shale and shells	225 - 730
Sand	730 - 765
Shale and sand	765 - 790
Sand	790 - 830
Shale and sand	830 - 975
Shale - sand strks.	975 - 1040
Sand	1040 - 1320
Shale - shells	1320 - 1566
Shale	1566 - 1591
Anhydrite	1591 - 1630
Shale and shells	1630 - 1840
Shale	1840 - 2110
Shale	2110 - 2242
Lime and shale	2242 - 2350
Ft. Riley lime	2350 - 2410
Lime - shale strks.	2410 - 2574
Shale - lime strks.	2574 - 2580
Lime and shale	2580 - 2682
Broken lime	2682 - 2824
Lime	2824 - 2890
Shale - lime	2890 - 2922
Lime and shale	2922 - 3017
Shale and lime	3017 - 3060
Shale and lime	3060 - 3170
Lime and shale	3170 - 3247
Shale and lime	3247 - 3297
Broken lime and shale strks	3297 - 3327
Lime	3327 - 3415
Lime - shale	3415 - 3460
Lime	3460 - 3611
Conglomerate	3611 - 3677
Conglomerate	3677 - 3755
Arbuckle	3755 - 3761

STATE OF KANSAS )  
                          ) SS  
SEDGWICK COUNTY )

I hereby certify that the above information is true and correct to the best of my knowledge.

*Walter England*

Subscribed and sworn to before me this 29 day of December, 1953.

*Waldemar Sogus*  
Notary Public

My Commission Expires: October 29, 1955

