

15-163-21481-0000

STATE OF KANSAS
STATE CORPORATION COMMISSION

FORM CP-4


WELL PLUGGING RECORD

Give All Information Completely
Make Required Affidavit
Mail or Deliver Report to
Conservation Division
State Corporation Comm.
200 Colorado Derby Bldg.
202 W. 1st St.
Wichita, KS 67202

Rooks County Sec. 4 Twp. 10s Rge. 19 E/W
Location as "NE/CNW/SW" or footage from lines
100' W NW/NW/SE

Lease Owner Guy Bemis d/b/a Black Gold Oil Company
Lease Name Joy Well No. #2
Office Address 1200 Main P.O. Box 26 Hays, Ks 67601
Character of Well (Completed as Oil, Gas or Dry Hole) Dry Hole

Date Well completed December 17 1981
Application for plugging filed December 17 1981
Application for plugging approved December 17 1981
Plugging commenced December 17 1981
Plugging completed 8:00 P.M. December 17 1981
Reason for abandonment of well or producing formation No Commercial Production

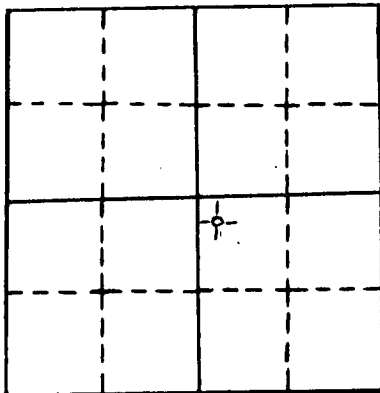

locate well correctly
on above
Section Plot

If a producing well is abandoned, date of last production
19

Was permission obtained from the Conservation Division or
its agents before plugging was commenced? Yes

Name of Conservation Agent who supervised plugging of this well Marion Schmidt
Producing formation _____ Depth to top _____ Bottom _____ Tl. Depth of Well _____
Show depth and thickness of all water, oil and gas formations.

OIL, GAS OR WATER RECORDS

CASING RECORD

FORMATION	CONTENT	FROM	TO	SIZE	PUT IN	PULLED OUT
Surface casing	common	0'	202.55'	8 5/8"	202.55'	0'

Describe in detail the manner in which the well was plugged, indicating where the mud fluid was placed and the method or methods used in introducing it into the hold. If cement or other plugs were used, state the character of same and depth placed, from _____ feet to _____ feet for each plug set.

Plug #1 850' with 70sxs

Plug #2 190' with 45sxs

Brought all the way up to the top

10sxs in rathole

Total ---125sxs 50-50pos 6%gel 3%cc

P.D. @ 8:00 P.M.

RECEIVED

STATE CORPORATION COMMISSION

1-5-82
JAN-5 1982

CONSERVATION DIVISION
Wichita Kansas

(If additional description is necessary, use BACK of this sheet)

Name of Plugging Contractor Pioneer Drilling Company

STATE OF Kansas COUNTY OF Ellis, ss.

Guy Bemis d/b/a Black Gold Oil Co. (~~employee of owner~~) or (owner or operator) of the above described well, being first duly sworn on oath, says: That I have knowledge of the facts, statements, and matters herein contained and the log of the above described well is filed and that the same are true and correct. So help me God.

(Signature) Guy Bemis

(Address) P. O. Box 26 Hays, Kansas 67601

SUBSCRIBED AND SWORN TO before me this 4th day of January, 19 82

My commission expires _____
ELLEN VAP
Rush County, Ks
My Appt. Exp. 12-1-82

Ellen Vap
Notary Public