


15-163-21560-0000

WELL PLUGGING RECORD

Give All Information Completely  
 Make Required Affidavit

COUNTY Rooks SEC. 4 TWP. 10 RGE. 19 E/W  
 Location as in quarters or footage from lines:  
W/2/SE/NW

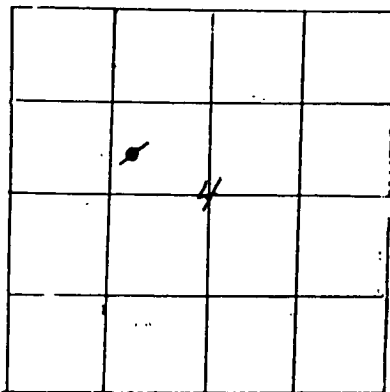

Locate Well  
 correctly on above  
 Section Platt.

Lease Owner Frontier Oil Company  
 Lease Name Andreson Well No. #3  
 Office Address 1437 N. Franklin - Russell, Ks. 67665  
 Character of Well (Completed as Oil, Gas or Dry Hole): Oil  
 Date Well Completed 3-22-82.  
 Application for plugging filed 6-10-83  
 Plugging commenced June 11, 1983  
 Plugging completed June 16, 1983  
 Reason for abandonment of well or producing formation Depleted

Was permission obtained from the Conservation Division or it's  
 Agent's before plugging was commenced? Yes

Name of Conservation Agent who supervised plugging of this well Dennis Hamel  
 Producing formation Arbuckle Depth to top 3736' bottom 3740' T.D. 3740'  
 Show depth and thickness of all water, oil and gas formations.

OIL, GAS OR WATER RECORDS

Casing Record

Formation	Content	From	To	Size	Put in	Pulled Out
				8 5/8"	262'	NONE
				4 1/2"	3738'	2515.83'

Describe in detail the manner in which the well was plugged, indicating where the mud  
 fluid was placed and the method or methods used in introducing it into the hold. If cement  
 or other plugs were used, state the character of same and depth placed, from        feet  
 to        feet for each plug set.

Dumped four (4) sacks cement, 75' sand and four (4) sacks cement.  
Shot pipe @ 3000' and 2500'.  
Pulled sixty-seven (67) joints 4 1/2" casing.  
Squeezed well with five (5) sacks hulls, thirty (30) sacks cement,  
one (1) sack huols, eight (8) sacks gel, seventy (70) sacks  
cement, ten (10) sacks gel, released plug and pumped sixty-five (65)  
sacks 50/50 pozmix cement, 6% gel, 500 lbs. max. press., 200 psi.

(If additional description is necessary, use BACK of this sheet)

Name of Plugging Contractor Rockhold Engineering, Inc.

STATE OF KANSAS COUNTY OF BARTON, ss.


James W. Rockhold (employee of owner) or (owner or operator) of the  
 above-described well, being first duly sworn on oath, says: That I have knowledge of the  
 facts, statements, and matters herein contained and the log of the above-described well as  
 filed and that the same are true and correct. So help me God.

STATE CORPORATION COMMISSION

7-5-83  
 JUL 05 1983

(Signature) James W. Rockhold  
 JAMES W. ROCKHOLD Box 698 - Great Bend, Ks.  
 (Address) 67530

CONSERVATION DIVISION  
 SUBSCRIBED AND SWORN TO before me this 29th day of June, 1983

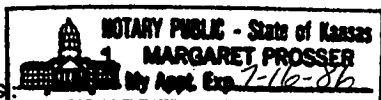

Margaret Prosser  
 Notary Public.

My Commission expires