

STATE OF KANSAS
STATE CORPORATION COMMISSION

WELL PLUGGING RECORD

Give All Information Completely
Make Required Affidavit
Mail or Deliver Report to
Conservation Division
State Corporation Comm.
245 North Water
Wichita, KS 67202

Rooks County Sec 4 Twp 10s Rge. 19 E/W
Location as "NE/CNW/SW" or footage from lines _____
SW NW SE

Lease Owner Black Gold Oil Company
Lease Name Joy Well No. 1
Office Address P.O. BOX 26 Hays, KS 67601

Character of Well (Completed as Oil, Gas or Dry Hole) _____
Dry Hole

Date Well completed May 13 19 81

Application for plugging filed may 13 19 81

Application for plugging approved May 13 19 81

Plugging commenced 2:30 A.M. May 13 19 81


Plugging completed 4:30 A.M. May 13 19 81

Reason for abandonment of well or producing formation _____
No commercial production

If a producing well is abandoned, date of last production _____
19 _____

Was permission obtained from the Conservation Division or
its agents before plugging was commenced? yes

Name of Conservation Agent who supervised plugging of this well Marion Schmidt
Producing formation _____ Depth to top _____ Bottom _____ Tl. Depth of Well _____
Show depth and thickness of all water, oil and gas formations.

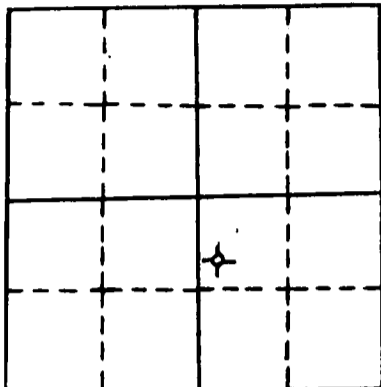

locate well correctly
on above
Section Plot

OIL, GAS OR WATER RECORDS

CASING RECORD

FORMATION	CONTENT	FROM	TO	SIZE	PUT IN	PULLED OUT
surface casing	common	0'	209.02'	8 5/8"	209.02'	0'

Describe in detail the manner in which the well was plugged, indicating where the mud fluid was placed and the method or methods used in introducing it into the hold. If cement or other plugs were used, state the character of same and depth placed, from _____ feet to _____ feet for each plug set.

Plug #1 800' with 65 sxs

Plug #2 240' with 30 sxs

Plug #3 40' with 10 sxs

1 sxs hulls & with solid bridge

5 sxs in rathole

Total 110 sxs 50/50 poz 6%gel

RECEIVED
STATE CORPORATION COMMISSION
5-26-81
MAY 26 1981
CONSERVATION DIVISION
Wichita, Kansas

(If additional description is necessary, use BACK of this sheet)

Name of Plugging Contractor Pioneer Drilling Company, Inc.
308 West Mill Plainville, KS 67663

STATE OF Kansas COUNTY OF Ellis, ss.

Guy Bemis d/b/a Black Gold Oil Company (employee of owner) or (owner or operator) of the above described well, being first duly sworn on oath, says: That I have knowledge of the facts, statements, and matters herein contained and the log of the above described well is filed and that the same are true and correct. So help me God.

(Signature) Guy Bemis
(Address) P. O. Box 26 Hays, KS. 67601

SUBSCRIBED AND SWORN TO before me this 22nd day of May, 19 81

My commission expires 12-1-82
ELLEN VAP
Notary Public
Rush County, KS.
My Appt. Exp.

Ellen Vap
Notary Public Ellen Vap

15-163-21257-0000

WELL LOG

OPERATOR: Black Gold Oil Company

WELL NAME: Joy #1 LOCATION: SW NW SE 4-10s-19W

COUNTY: Rooks STATE: Kansas

WELL COMMENCED: May 6, 1981 WELL COMPLETED: May 13, 1981

ELEVATION: 2175' K.B. TOTAL DEPTH: 3744'

PRODUCTION: D & A RIG NO: #2

CASING - 8 5/8" 209.02' used 28# cemented with 85 sxs common 2% gel 3% cc did circ
5 1/2": _____

ALL MEASUREMENTS TAKEN FROM THE TOP OF ROTARY BUSHING:

FROM	TO	FORMATION	DEVIATION FROM VERTICAL	REMARKS:
0'	325'			
325'	1180'	sand and shale		
1180'	1558'	sand and shale		
1558'	1595'	Anhydrite		
1595'	1792'	sand and shale		
1792'	2040'	sand and shale	2040' - 1 1/4 - degree	
2040'	2095'	sand and shale		
2095'	2260'	sand, shale, lime		
2260'	2480'	lime and shale		
2480'	2735'	lime and shale		
2735'	2900'	lime and shale		
2900'	3070'	lime and shale		
3070'	3220'	lime and shale		
3220'	3330'	lime and shale		
3330'	3435'	lime and shale		
3425'	3465'	lime and shale	3465' - 1/2 - degree	
3465'	3515'	lime and shale		
3515'	3578'	lime and shale		
3578'	3663'	lime and shale	3663' - 1 - degree	
3663'	3720'	lime and shale		
3720'	3774'	lime and shale		
3774'	RTD			


RECEIVED
STATE CORPORATION COMMISSION

MAY 22 1981

CONSERVATION DIVISION
Wichita, Kansas

STATE OF KANSAS
COUNTY OF

The undersigned hereby certifies that to the best of his knowledge and belief, the above facts are true and correct

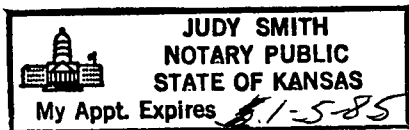

PIONEER DRILLING CO., INC.

By Cornie J. Austin

SUBSCRIBED AND SWORN TO, BEFORE ME, This 21st day of May, 1981

Judy Smith
NOTARY PUBLIC