


STATE OF KANSAS
STATE CORPORATION COMMISSION

WELL PLUGGING RECORD

Give All Information Completely
Make Required Affidavit
Mail or Deliver Report to:
Conservation Division
State Corporation Commission
800 Bitting Building
Wichita, Kansas

Rooks County. Sec. 5 Twp. 10 Rge. 19 (E) 19 (W)
Location as "NE/CNW $\frac{1}{4}$ SW $\frac{1}{4}$ " or footage from lines SW SW SW
Lease Owner Westgate-Greenland Oil Company
Lease Name Suter Well No. 1
Office Address 1009 Central Building, Wichita 2, Kansas
Character of Well (completed as Oil, Gas or Dry Hole) dry hole
Date well completed March 28, 1951 19
Application for plugging filed (orally) March 28, 1951 19
Application for plugging approved " March 28, 1951 19
Plugging commenced March 28, 1951 19
Plugging completed March 28, 1951 19
Reason for abandonment of well or producing formation
If a producing well is abandoned, date of last production 19
Was permission obtained from the Conservation Division or its agents before plugging was commenced? yes

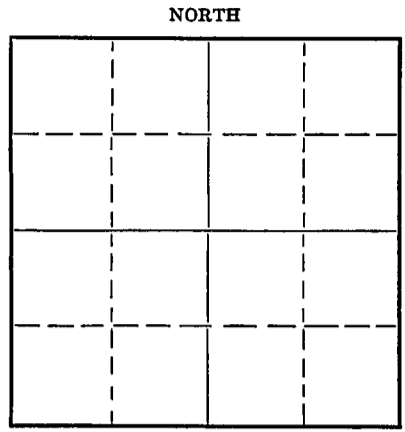

Locate well correctly on above Section Plat

Name of Conservation Agent who supervised plugging of this well Eldon Petty
Producing formation Depth to top Bottom Total Depth of Well Feet
Show depth and thickness of all water, oil and gas formations.

OIL, GAS OR WATER RECORDS

CASING RECORD

Formation	Content	From	To	Size	Put In	Pulled Out
surface		0	202	8 5/8"	202	none

Describe in detail the manner in which the well was plugged, indicating where the mud fluid was placed and the method or methods used in introducing it into the hole. If cement or other plugs were used, state the character of same and depth placed, from feet to feet for each plug set.

Filled hole with heavy mud from 3848 to 185 feet
Set Halliburton plug at 185 feet and ran 15 sacks cement to 137 feet, filled with heavy mud to 35 feet
Set Halliburton plug at 35 feet and ran 10 sacks cement to cellar.

4-4-51

(If additional description is necessary, use BACK of this sheet)
Correspondence regarding this well should be addressed to Westgate-Greenland Oil Company
Address 1009 Central Building, Wichita 2, Kansas

STATE OF Kansas, COUNTY OF Sedgwick, ss.
G. E. Bitler (employee of owner) of the above-described well, being first duly sworn on oath, says: That I have knowledge of the facts, statements, and matters herein contained and the log of the above-described well as filed and that the same are true and correct. So help me God.

(Signature) G. E. Bitler
1009 Central Building, Wichita 2, Kansas (Address)

SUBSCRIBED AND SWORN to before me this 4th day of April, 1951
Esther Russell Notary Public.

My commission expires May 25, 1953.

PLUGGING
FILE SEC—T—R—
BOOK PAGE—LINE—

COMPANY: Westgate Greenland Oil Co.
 CONTRACTOR: Jackson Drilling Corporation
 FARM: Sutor #1
 LOCATION: SW SW SW Section 5-10-19
 Rooks County, Kansas
 ELEVATION: 2220
 COMMENCED: March 16, 1951
 COMPLETED: March 28, 1951

0	to	90	Soil, Sand and Gravel
90	to	525	Shale
525	to	600	Shale and Shells
600	to	740	Shale
740	to	780	Sand and Shale
780	to	865	Redbed and Shale
865	to	925	Shale w/Sand
925	to	983	Sand
983	to	1104	Shale
1104	to	1370	Sand
1370	to	1445	Redbed and Shale
1445	to	1653	Redbed
1653	to	1686	Anhydrite
1686	to	2199	Shale and Shells
2199	to	2300	Lime
2300	to	3344	Lime and Shale
3344	to	3435	Lime
3435	to	3465	Lime w/Shale
3465	to	3678	Lime
3678	to	3728	Shale and Lime
3728	to	3747	Conglomerate
3747	to	3750	Simpson
3750	to	3778	Conglomerate
3778	to	3795	Shale
3795	to	3850	Arbuckle
		3850 T.D.	

8 5/8" casing set at 204 feet. Cemented with 150 sacks cement and 2 sacks calcium chloride.
 Drill stem test at 3648. Open 30 minutes - recovered 4 feet of slightly oil
 topped mud.

Tops - Lansing 3477
 Arbuckle 3795

Dry and abandoned

All measurements from top of derrick floor.

C E R T I F I C A T E

I, Clare A. Stewart, do hereby certify that the above and foregoing is a true and correct copy of log of Sutor #1, Section 5-10-19, Rooks County, Kansas, as reflected by the files of the Jackson Drilling Corporation.

Clare A. Stewart

 Clare A. Stewart

Subscribed and sworn to before me, a Notary Public, within and for Johnson County, Kansas, this 30th day of March, 1951.

PLUGGING
 FILE SEC 5 T 10 R 19W
 BOOK PAGE 70 LINE 34

Dorothy J. Wilson

 Dorothy J. Wilson