

WELL PLUGGING RECORD

Give All Information Completely
Make Required Affidavit
Mail or Deliver Report to:
Conservation Division
State Corporation Commission
800 Bittling Building
Wichita, Kansas

Rooks County. Sec. 5 Twp. 10S Rge. 19 (W)

Location as "NE/CNW $\frac{1}{4}$ SW $\frac{1}{4}$ " or footage from lines C-NE NE NE

Lease Owner Sunray Oil Corporation

Lease Name M. Sutor Well No. 1

Office Address Box 195, Great Bend, Kansas

Character of Well (completed as Oil, Gas or Dry Hole) Dry Hole

Date well completed June 24, 1951

Application for plugging filed June 27, 1951

Application for plugging approved June 26, 1951


Plugging commenced June 24, 1951

Plugging completed June 24, 1951

Reason for abandonment of well or producing formation Dry Hole

If a producing well is abandoned, date of last production 19

Was permission obtained from the Conservation Division or its agents before plugging was commenced? Yes

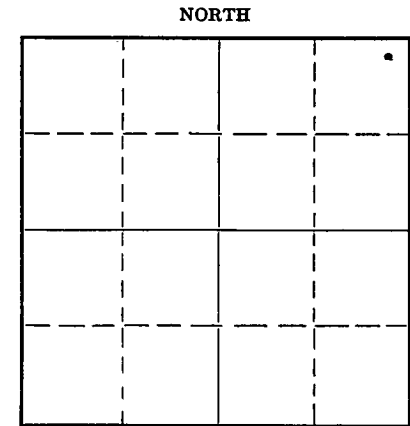

Locate well correctly on above Section Flat

Name of Conservation Agent who supervised plugging of this well Eldon Petty

Producing formation None Depth to top Bottom Total Depth of Well 3808 Feet

Show depth and thickness of all water, oil and gas formations.

OIL, GAS OR WATER RECORDS

CASING RECORD

Formation	Content	From	To	Size	Put In	Pulled Out
Lansing-KC	Wtr.sl sh oil	3454	3661	8-5/8"	1603'	None
Conglomerate	Water	3702	3808			
Arbuckle Not Encountered						

Describe in detail the manner in which the well was plugged, indicating where the mud fluid was placed and the method or methods used in introducing it into the hole. If cement or other plugs were used, state the character of same and depth placed, from feet to feet for each plug set.

Hole filled w/heavy mud to 250'. Spotted plug and filled up from, 250' to 205', with 15 sax. Mudded up to 40' and filled up from 40' to 10' with 10 sax.

(If additional description is necessary, use BACK of this sheet)

Correspondence regarding this well should be addressed to Sunray Oil Corporation
Address Box 195, Great Bend, Kansas

STATE OF KANSAS, COUNTY OF BARTON, ss.


W. E. Westbrook, Jr. (employee of owner) of the above-described well, being first duly sworn on oath, says: That I have knowledge of the facts, statements, and matters herein contained and the log of the above-described well as filed and that the same are true and correct. So help me God.

(Signature) W. E. Westbrook, Jr. Engineer
Box 195, Great Bend, Kansas (Address)

SUBSCRIBED AND SWORN to before me this 28th day of June, 1951.

Martha Scott Notary Public.

My commission expires April 19, 1951

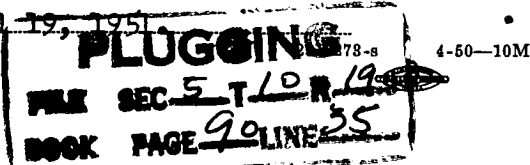

Tulsa, Oklahoma
June 26, 1951

Sunray Oil Corporation
Tulsa, Oklahoma

CONTRACTOR: STICKLE DRILLING COMPANY
Drilling commenced: June 9, 1951
Drilling completed: June 24, 1951

Mabel Sutor #1 NE-NE-NE-
Sec. 5-10S-19W, Rooks
County, Kansas.

DRILLERS LOG

Shale	0-130
Sand & Shale	130-170
Shale	170-260
Shale & Shells	260-550
Shale	550-760
Sand	760-800
Shale	800-895
Sand	895-925
Shale	925-1040
Sand & Shale	1040-1150
Shale	1150-1290
Shale & Shells	1290-1450
Red Bed	1450-1595
Anhydrite	1595-1645
Shale	1645-1955
Shale & Lime	1955-2070
Shale & Shells	2070-2310
Shale & Lime	2310-2800
Lime & Shale	2800-2955
Shale & Lime	2955-3337
Lime & Shale	3337-3370
Lime	3370-3747
Shale	3747-3755
Chert	3755-3808 TD

I, Lillian T. Bonham, hereby certify the above to be a true and complete
drillers log of Sunray Oil Corporation's Mabel Sutor #1 NE-NE-NE-
Section 5-10S-19W, Rooks County, Kansas.

Lillian T. Bonham
Lillian T. Bonham

Edward G. Fickel
Notary Public

June 26, 1952
My commission expires

PLUGGING
FILE SEC 5-10-19W
BOOK PAGE 90 LINE 35

RECORDED
INDEXED
JUN 27 1952
R. B. BROWN