


STATE OF KANSAS
STATE CORPORATION COMMISSION

WELL PLUGGING RECORD

Give All Information Completely
Make Required Affidavit
Mail or Deliver Report to:
Conservation Division
State Corporation Commission
800 Bittling Building
Wichita, Kansas

NORTH

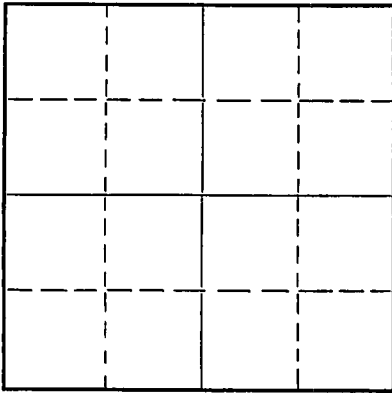

Locate well correctly on above
Section Plat

Rooks County. Sec. **5** Twp. **10S** Rge. **19** (E) **19** (W)
Location as "NE/CNW $\frac{1}{4}$ SW $\frac{1}{4}$ " or footage from lines **NE NE SW**
Lease Owner **JONES, SHELBOURNE & FARMER, INC.**
Lease Name **Suter B** Well No. **1**
Office Address **Russell, Kansas**
Character of Well (completed as Oil, Gas or Dry Hole) **Dry hole**
Date well completed **7-14** **1951**
Application for plugging filed **7-14** **1951**
Application for plugging approved **7-14** **1951**
Plugging commenced **7-14** **1951**
Plugging completed **7-14** **1951**
Reason for abandonment of well or producing formation **Dry**

If a producing well is abandoned, date of last production **Never Produced** 19...
Was permission obtained from the Conservation Division or its agents before plugging was commenced? **Yes**

Name of Conservation Agent who supervised plugging of this well **Elden Petty**
Producing formation..... Depth to top..... Bottom..... Total Depth of Well **3885** Feet
Show depth and thickness of all water, oil and gas formations.

OIL, GAS OR WATER RECORDS

CASING RECORD

Formation	Content	From	To	Size	Put In	Pulled Out

Describe in detail the manner in which the well was plugged, indicating where the mud fluid was placed and the method or methods used in introducing it into the hole. If cement or other plugs were used, state the character of same and depth placed, from.....feet to.....feet for each plug set.

- Hole was filled with heavy mud to top**
- Halliburton plug pushed to 160'**
- 1/2 sack hulls dumped on top of plug**
- 15 sacks cement mixed and spotted on top of hulls**
- Second Halliburton plug pushed to 40'**
- 1/2 sack of hulls dumped on top of plug**
- 10 sacks cement mixed and hole filled to top with same.**

7-20-51

(If additional description is necessary, use BACK of this sheet)
Correspondence regarding this well should be addressed to **JONES, SHELBOURNE & FARMER, INC.**
Address **Russell, Kansas**

STATE OF **KANSAS**, COUNTY OF **RUSSELL**, ss.
John O. Farmer (employee of owner) or (owner or operator) of the above-described well,
being first duly sworn on oath, says: That I have knowledge of the facts, statements, and matters herein contained and the log of the above-described well as filed and that the same are true and correct. So help me God.

(Signature) **John O. Farmer**
Russell, Kansas
(Address)

SUBSCRIBED AND SWORN to before me this **16th** day of **July**, 19**51**.
Josephine E. Waag
Notary Public.

My commission expires **February 19, 1955**
28-3278-s 4-50-10M

PLUGGING
FILE SEC **5 T 10 R 19**
BOOK PAGE **96** LINE **17**

Jones, Shelburne & Farmer, Inc.

Russell, Kansas

CONTRACTOR'S VERIFIED LOG

Operator JONES, SHELBURNE & FARMER, INC Farm Name SUTOR B Well No. 1

Location NE NE SW 5-10S-19W

Pool Name Wildcat County Rooks State Kansas

Commencement Date July 2, 1951 Completion Date July 14, 1951

Log of Well

Depth		Formation	Deviation from vertical (degrees)	Remarks
From	To			
0	1120	Shale, shells & sand		
1120	1410	Sand, shells		
1410	1470	Red rock, shale		
1470	1635	Shale & shells		
1635	1670	Anhydrite		
1670	2260	Shale & shells		
2260	2375	Shale & lime		
2375	2670	Lime & shale		
2670	2795	Shale & lime		
2795	2865	Lime & shale		
2865	2930	Shale & lime		
2930	3430	Lime & shale		
3430	3465	Shale & lime		
3465	3475	Lime & shale		
3475	3555	Lime		
3555	3575	Lime & shale		
3575	3740	Lime		
3740	3870	Conglomerate		
3870	3885	Lime		

PLUGGING
 FILE SEC 5 T 10 R 19W
 BOOK PAGE 96 LINE YY

