


WELL PLUGGING RECORD

Give All Information Completely
Make Required Affidavit
Mail or Deliver Report to:
Conservation Division
State Corporation Commission
212 No. Market
Wichita, Kansas

NORTH

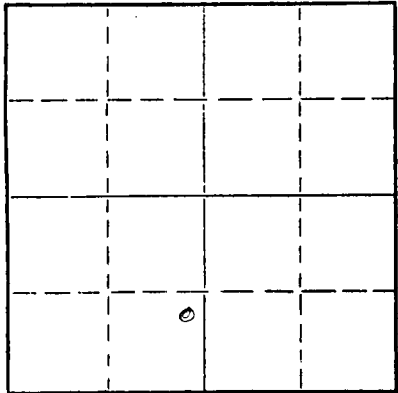

Locate well correctly on above
Section Plat

Rooks County. Sec. 5 Twp. 10S Rge. (E) 19 (W)
Location as "NE/CNW%SW%" or footage from lines NE SE SW
Lease Owner Allison & Black
Lease Name #1 Sutor Well No. 1
Office Address 1415 Wichita Plaza - Wichita, Kansas
Character of Well (completed as Oil, Gas or Dry Hole) dry
Date well completed July 21 1967
Application for plugging filed July 21 1967
Application for plugging approved July 21 1967
Plugging commenced July 21 7:30 PM 1967
Plugging completed July 22 1:15AM 1967
Reason for abandonment of well or producing formation dry

If a producing well is abandoned, date of last production none 19
Was permission obtained from the Conservation Division or its agents before plugging was commenced? Yes

Name of Conservation Agent who supervised plugging of this well Leo Massey - Hays, Kansas
Producing formation none Depth to top Bottom Total Depth of Well 3798 Feet
Show depth and thickness of all water, oil and gas formations.

OIL, GAS OR WATER RECORDS

CASING RECORD

FORMATION	CONTENT	FROM	TO	SIZE	PUT IN	PULLED OUT
Sand & Shale		0	215	8 5/8	212	0

Describe in detail the manner in which the well was plugged, indicating where the mud fluid was placed and the method or methods used in introducing it into the hole. If cement or other plugs were used, state the character of same and depth placed, from feet to feet for each plug set.

Plug hole - Set plug at 800' cemented with 90 sacks through drill pipe
Filled hole to 200' with 20 sacks. Filled hole to 40' with 10 sacks
to hold bridge and kelly weight. 2 sacks in rat hole.

RECEIVED
7-25-67
AUG. 25 1967
CONSERVATION DIVISION
WICHITA, KANSAS

(If additional description is necessary, use BACK of this sheet)
Name of Plugging Contractor B & B Drilling, Inc.
Address 548 Petroleum Building - Wichita, Kansas

STATE OF Kansas, COUNTY OF Sedgwick, ss.
Bill Lahar (employee of owner) or (owner or operator) of the above-described well, being first duly sworn on oath, says: That I have knowledge of the facts, statements, and matters herein contained and the log of the above-described well as filed and that the same are true and correct. So help me God.

(Signature) Bill Lahar
548 Petroleum Building - Wichita, Kansas
(Address)

SUBSCRIBED AND SWORN TO before me this 24th day of July, 1967

My commission expires May 31, 1970
Alma A. Neiser Notary Public.

B & B DRILLING, INC.

15-163-20033-0000

548 Petroleum Building
Wichita, Kansas 67202

July 24, 1967

DRILLERS LOG

Re: #1 Sutor
NE SE SW
Section 5-10S-19W
Rooks County, Kansas

COMPANY: Allison & Black
CONTRACTOR: B & B Drilling, Inc.
TOTAL DEPTH: 3798'
COMMENCED: July 13, 1967
COMPLETED: July 21, 1967

RECEIVED
STATE CORPORATION COMMISSION

JUL 25 1967

CONSERVATION DIVISION
Wichita, Kansas

0	215	Sand & Shale		
212	1300	Shale & Shells		
1300	1649	Shale		
1649	1679	Anhrhrite Lime		
1679	2133	Shale & Lime		
2133	2433	Shale & Lime		
2433	2523	Shale & Lime		
2523	2579	Lime		
2579	2874	Shale & Lime		
2874	3063	Shale & Lime	Anhy.	1649
3063	3270	Shale & Lime	Reebner	3430
3270	3375	Shale & Lime	Toranto	3452
3375	3485	Lime	Lansing	3467
3485	3541	Lime	Arbuckle	3772
3541	3596	Lime		
3596	3650	Lime		
3650	3680	Lime		
3680	3757	Lime		
3757	3779	Lime		
3779	3779	DST # 1		
3779	3783	Lime DST # 2		
3783	3788	Lime		
3788	3798	Lime DST # 3		
3798		Total Depth DST # 4 D & A		

We certify the above and foregoing to be true and correct copy of the log on the #1 Sutor, located in Rooks County, Kansas

Bill Lohar President

Alma A. Miller Notary Public

Subscribed and sworn to before me this 24th day of July. My commission expires May 31, 1970