


Give All Information Completely  
Make Required Affidavit  
Mail or Deliver Report to:  
Conservation Division  
State Corporation Commission  
211 No. Broadway  
Wichita, Kansas

WELL PLUGGING RECORD

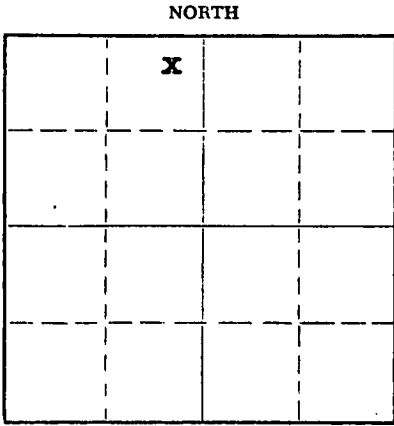

Locate well correctly on above Section Plat

Rooks County. Sec. 5 Twp. 10S Rge. 19 (W)  
Location as "NE/CNW&SW" or footage from lines NE NE NW  
Lease Owner Continental Oil Company  
Lease Name L. A. Hamel Well No. 1  
Office Address Drawer 98, Plainville, Kansas  
Character of Well (completed as Oil, Gas or Dry Hole) Dry hole  
Date well completed December 1 1960  
Application for plugging filed December 1 1960  
Application for plugging approved December 1 1960  
Plugging commenced December 1 1960  
Plugging completed December 1 1960  
Reason for abandonment of well or producing formation No geological shows in Lansing or Arbuckle formations  
If a producing well is abandoned, date of last production \_\_\_\_\_ 19\_\_\_\_  
Was permission obtained from the Conservation Division or its agents before plugging was commenced? yes

Name of Conservation Agent who supervised plugging of this well Mr. Eldon Petty  
Producing formation None Depth to top \_\_\_\_\_ Bottom \_\_\_\_\_ Total Depth of Well 3,825 Feet  
Show depth and thickness of all water, oil and gas formations.

OIL, GAS OR WATER RECORDS

CASING RECORD

FORMATION	CONTENT	FROM	TO	SIZE	PUT IN	PULLED OUT
Surface				8-5/8"OD	221'	None

Describe in detail the manner in which the well was plugged, indicating where the mud fluid was placed and the method or methods used in introducing it into the hole. If cement or other plugs were used, state the character of same and depth placed, from \_\_\_\_\_ feet to \_\_\_\_\_ feet for each plug set.

Filled hole with heavy mud, set plug at 550 feet and cemented through pipe with 20 sacks of cement. Mudded hole up to 180 feet, set plug and cemented with 20 sacks of cement. Mudded to 40 feet. Set plug and dumped one-half sack of hull. Cemented to base of cellar with 10 sacks of cement.

RECEIVED  
12-2-60  
DEC 2 1960

(If additional description is necessary, use BACK of this sheet)  
Name of Plugging Contractor Halliburton Company  
Address Hays, Kansas

STATE OF Kansas, COUNTY OF Rooks, ss.  
L. E. Powell (employee of owner) or (owner or operator) of the above-described well, being first duly sworn on oath, says: That I have knowledge of the facts, statements, and matters herein contained and the log of the above-described well as filed and that the same are true and correct. So help me God.

(Signature) L. E. Powell  
Drawer 98, Plainville, Kansas  
(Address)

SUBSCRIBED AND SWORN TO before me this 1st day of December, 19 60

My commission expires December 2, 1961  
Kenneth J. Query Notary Public.

RGW-drs  
State Corp. Comm.  
DWM  
File

WHITE  
CORRECT  
COMM.

# WELL LOG

15-163-19417-0000

COMPANY CONTINENTAL OIL COMPANY

SEC. 5 T. 10S R. 19W

FARM HAMEL NO. 1


LOC. NE, NE, NW

TOTAL DEPTH 3825'

COUNTY ROOKS CO., KANSAS

COMM. November 23, 1960 COMP. December 1, 1960

CONTRACTOR GARVEY DRILLING COMPANY

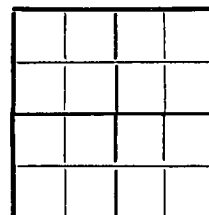

CASING 8 5/8" @ 229' w/150 sax.

ELEVATION 2224' DF

PRODUCTION D & A

FIGURES INDICATE BOTTOM OF FORMATIONS

40	Top soil & clay
885	Shale
935	Sand
1050	Shale
1305	Sand
1635	Shale & shells
1675	Anhydrite
2220	Shale & shells
2455	Lime & shale
2805	Shale & lime
3408	Lime & shale
3740	Lime
3785	Lime & conglomerate
3808	Lime & chert
3825	Arbuckle
3825	T. D.

Garvey Drilling Company  
Notary Public  
Commission Expires  
November 12, 1962

State of KANSAS }  
County of BARTON } ss.

I, VERNE A. MORRIS of GARVEY DRILLING COMPANY

upon oath state that the above and foregoing is a true and correct copy of the log of the #1 HAMEL well

Verne A. Morris

Subscribed and sworn to before me this 16th day of December 19 60

My Commission Expires: November 12, 1962

Garvey  
NOTARY PUBLIC