

15-163-21325-0000


STATE OF KANSAS  
STATE CORPORATION COMMISSION

WELL PLUGGING RECORD

Give All Information Completely  
Make Required Affidavit  
Mail or Deliver Report to  
Conservation Division  
State Corporation Comm.  
245 North Water  
Wichita, KS 67202

Rooks County. Sec. 6 Twp. 10S Rge. 19 E/W  
Location as "NE/CNW $\frac{1}{4}$ SW $\frac{1}{4}$ " or footage from lines  
SE/4 NE/4 NW/4

Lease Owner Wamego Oil, Inc.  
Lease Name Steeples Well No. #1  
Office Address 200 Research Dr., Suite G, Manhattan, Kansas  
Character of Well (Completed as Oil, Gas or Dry Hole) 66502  
Dry Hole

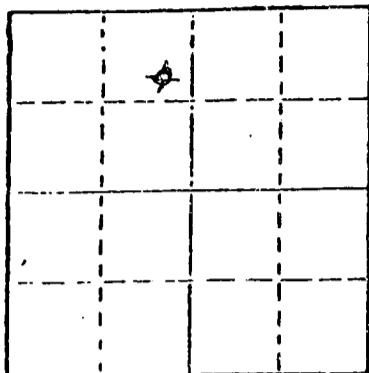

Locate well correctly on above  
Section Plat

Date Well completed 10-21 19 81  
Application for plugging filed 10-21 19 81  
Application for plugging approved 10-21 19 81  
Plugging commenced 10-21 19 81  
Plugging completed 10-21 19 81

Reason for abandonment of well or producing formation  
Dry Hole

If a producing well is abandoned, date of last production 19.

Was permission obtained from the Conservation Division or  
its agents before plugging was commenced? Yes

Name of Conservation Agent who supervised plugging of this well Gilbert Balthazor  
Producing formation \_\_\_\_\_ Depth to top \_\_\_\_\_ Bottom \_\_\_\_\_ Total Depth of Well \_\_\_\_\_  
Show depth and thickness of all water, oil and gas formations.

OIL, GAS OR WATER RECORDS

CASING RECORD

FORMATION	CONTENT	FROM	TO	SIZE	PUT IN	PULLED OUT
				8-5/8"	280'	-0-

Describe in detail the manner in which the well was plugged, indicating where the mud fluid  
was placed and the method or methods used in introducing it into the hold. If cement or other  
plugs were used, state the character of same and depth placed, from \_\_\_\_\_ feet to  
\_\_\_\_\_ feet for each plug set.

Mud laden fluid 3816' to 950'  
70 sx cement @ 950'  
40 sx cement @ 240'  
10 sx cement @ 40'  
10 sx cement in Rat Hole

(If additional description is necessary, use BACK of this sheet)

Name of Plugging Contractor Ranger Drilling Company, Inc.  
P.O. box 856, Hays, Kansas 67601

STATE OF KANSAS COUNTY OF ELLIS, ss.  
Robert R. Price (employee of owner) or (owner or operator)  
of the above-described well, being first duly sworn on oath, says: That I have knowledge of  
the facts, statements, and matters herein contained and the log of the above-described well  
as filed and that the same are true and correct. So help me God.

(Signature) Robert R. Price mlk

(Address)

SUBSCRIBED AND SWORN TO before me this 9th day of November, 19 81

Mary L. Kehm  
Notary Public.

My commission expires 8-6-85



RECEIVED  
STATE CORPORATION COMMISSION  
11-23-81  
NOV 23 1981

CONSERVATION DIVISION  
Wichita, Kansas