


STATE OF KANSAS  
STATE CORPORATION COMMISSION  
Give All Information Completely  
Make Required Affidavit  
Mail or Deliver Report to:  
Conservation Division  
State Corporation Commission  
211 No. Broadway  
Wichita, Kansas

WELL PLUGGING RECORD

Rooks County. Sec. 6 Twp. 10 Rge. 19 (E) W (W)  
Location as "NE/CNW/SW" or footage from lines SE SW NW  
Lease Owner Nadel and Gussman  
Lease Name Pywell Well No. B-1  
Office Address 1714 First National Bldg., Tulsa 3, Oklahoma  
Character of Well (completed as Oil, Gas or Dry Hole) Dry  
Date well completed 6-24 1957  
Application for plugging filed 6-24 1957  
Application for plugging approved 6-24 1957  
Plugging commenced 6-24 1957  
Plugging completed 6-24 1957  
Reason for abandonment of well or producing formation Dry

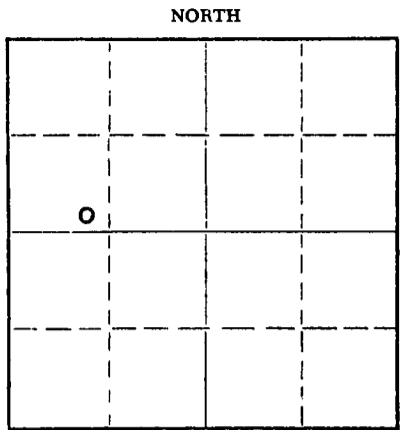

Locate well correctly on above Section Plat

If a producing well is abandoned, date of last production \_\_\_\_\_ 19\_\_\_\_  
Was permission obtained from the Conservation Division or its agents before plugging was commenced? Yes

Name of Conservation Agent who supervised plugging of this well Eldon Petty  
Producing formation \_\_\_\_\_ Depth to top \_\_\_\_\_ Bottom \_\_\_\_\_ Total Depth of Well 3835 Feet  
Show depth and thickness of all water, oil and gas formations.

OIL, GAS OR WATER RECORDS

CASING RECORD

FORMATION	CONTENT	FROM	TO	SIZE	PUT IN	PULLED OUT
				8-5/8"	184'	0

Describe in detail the manner in which the well was plugged, indicating where the mud fluid was placed and the method or methods used in introducing it into the hole. If cement or other plugs were used, state the character of same and depth placed, from \_\_\_\_\_ feet to \_\_\_\_\_ feet for each plug set.

Filled hole with heavy mud from total depth to 550' and cemented with 25 sax

Set top plug at 40' and cemented with 10 sax

7-2-57


(If additional description is necessary, use BACK of this sheet)  
Name of Plugging Contractor Reserve Drilling Company, Inc.  
Address 625 Union Center, Wichita 2, Kansas

STATE OF KANSAS, COUNTY OF SEDGWICK, ss.  
L. C. Hay (employee of owner) of the above-described well, being first duly sworn on oath, says: That I have knowledge of the facts, statements, and matters herein contained and the log of the above-described well as filed and that the same are true and correct. So help me God.

(Signature) L. C. Hay  
Wichita, Kansas (Address)

SUBSCRIBED AND SWORN TO before me this 25th day of June 1957

My commission expires Nov. 3, 1960 Notary Public.

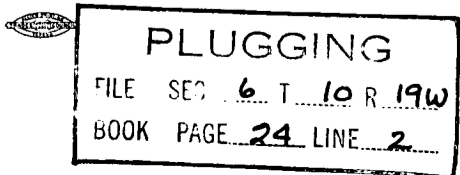

15-163-02550000

Nadel and Gussman

PYWELL WELL B-1

SE SW NW 6-10-19W  
Rooks County, Kansas  
Casing: 8-5/8" 184' w/125 sax

Comm: 6-14-57  
Comp: 6-24-57

<u>Formations</u>	<u>Depths</u>
Sand and shale	184
Shale, sand and shells	1315
Shale and red beds	1620
Anhydrite	1690
Shale and shells	2255
Shale and lime	3275
Lime	3660
Lime and shale	3735
Chert	3780
Chert and shale	3810
Lime	3814
Arbuckle	3835

GEOLOGICAL TOPS

Heebner	3444'
Toronto Lime	3464'
Lans-Kansas City	3482'
B. Kansas City	3697'
Basal Penn. Cong.	3750'
Simpson Shale	3806'
Arbuckle Dolomite	3813'
T.D.	3835'

STATE OF KANSAS }  
COUNTY OF SEDGWICK } SS:

L. C. Hay, of lawful age, states that the above formations and depths are correct to his best knowledge and belief.

L. C. Hay

Subscribed and sworn to before me this 27th day of June, 1957.

[Signature]  
Notary Public

My commission expires Nov. 3, 1960

PLUGGING  
SEC. 6 T. 10 R. 19W.  
PAGE 20 LINE 2