


STATE OF KANSAS
STATE CORPORATION COMMISSION

WELL PLUGGING RECORD

Give All Information Completely
Make Required Affidavit
Mail or Deliver Report to:
Conservation Division
State Corporation Commission
800 Bittling Building
Wichita, Kansas

Rooks County. Sec. 6 Twp. 10 Rge. 19 (X) W (W)
Location as "NE/CNW/SW" or footage from lines NE SE NW
Lease Owner Nadel and Gussman
Lease Name Skelly-Pywell Well No. 1
Office Address Box 309, Tulsa, Oklahoma
Character of Well (completed as Oil, Gas or Dry Hole) Dry
Date well completed 4-24 1954
Application for plugging filed 4-24 1954
Application for plugging approved 4-24 1954
Plugging commenced 4-24 1954
Plugging completed 4-24 1954
Reason for abandonment of well or producing formation Dry

NORTH

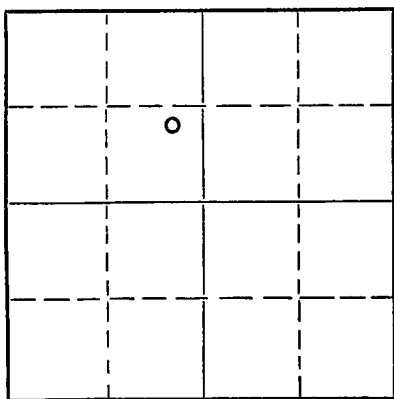

Locate well correctly on above
Section Plat

If a producing well is abandoned, date of last production _____ 19____
Was permission obtained from the Conservation Division or its agents before plugging was commenced? Yes

Name of Conservation Agent who supervised plugging of this well Eldon Petty
Producing formation _____ Depth to top _____ Bottom _____ Total Depth of Well 3894 Feet
Show depth and thickness of all water, oil and gas formations.

OIL, GAS OR WATER RECORDS

CASING RECORD

FORMATION	CONTENT	FROM	TO	SIZE	PUT IN	PULLED OUT
				8-5/8"	140'	0

Describe in detail the manner in which the well was plugged, indicating where the mud fluid was placed and the method or methods used in introducing it into the hole. If cement or other plugs were used, state the character of same and depth placed, from _____ feet to _____ feet for each plug set.

Filled hole with heavy mud from 3894' to 140'
Set plug and cemented with 15 sacks cement.
Set plug at 40' and cemented with 10 sacks cement.

(If additional description is necessary, use BACK of this sheet)


Name of Plugging Contractor Reserve Drilling Company, Inc.
Address 703 Union National Bank Bldg. Wichita 2, Kansas

STATE OF KANSAS, COUNTY OF SEDGWICK, ss.
L. C. Hay (employee of owner) of the above-described well, being first duly sworn on oath, says: That I have knowledge of the facts, statements, and matters herein contained and the log of the above-described well as filed and that the same are true and correct. So help me God.

(Signature) L. C. Hay
Wichita, Kansas (Address)

SUBSCRIBED AND SWORN TO before me this 29th day of April, 1954

My commission expires Nov. 3, 1956
Notary Public.

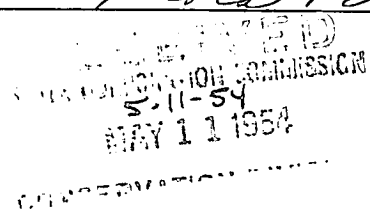

WELL LOG

NADEL AND GUSSMAN

SKELLY-PYWELL No. 1

NE SE NW 6-10-19W
Rooks County, Kans.

Comm: 4-14-54
Comp: 4-24-54

Casing: 3-5/8" 140' w/100 sax

<u>Formations</u>	<u>Depth</u>
Surface	50
Sand and shale	970
Sand, shale and shells	1565
Shale and shells	1647
Anhydrite	1684
Shale and red bed	1875
Shale and shells	2175
Shale and lime	2290
Lime	2425
Lime and shale	3545
Lime	2550
Lime and shale	3355
Shale and broken lime	3415
Shale and lime	3510
Lime	3690
Conglomerate	3884
Arbuckle	3890

Geological Tops

Heebner Shale	3436
Lansing-Kansas City	3476
Base Kansas City	3689
Conglomerate	3731
Arbuckle	3884

STATE OF KANSAS)
(SS:
COUNTY OF SEDGWICK)

L. C. Hay, of lawful age, deposes and states that the above depths and formations are correct as shown by the daily drilling log of the Skelly-Pywell Well No. 1 in the NE SE NW 6-10-19W, Rooks County, Kansas.

L. C. Hay

Subscribed and sworn to before me this 29th day of April, 1954.

W. C. Bush

Notary Public

My commission expires Nov. 3, 1956

PLUGGING

PLUG SEC 6 T 10 R 19W
PAGE 30 LINE 4