


STATE OF KANSAS
STATE CORPORATION COMMISSION
200 Colorado Derby Bldg.
Wichita, Kansas 67202

Form CP-4
Rev. 12-15-80

WELL PLUGGING RECORD

Give All Information Completely
Make Required Affidavit

COUNTY Rooks SEC. 6 TWP 10S RGE. 19W E/W
Location as in quarters or footage from lines:
NE SW SW

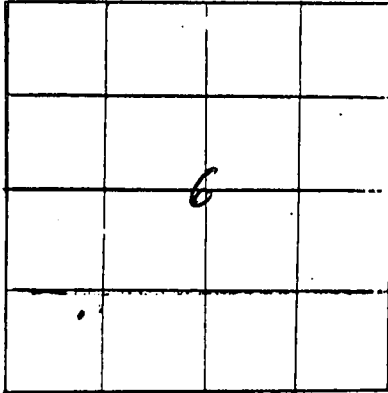

Locate Well
correctly on above
Section Platt.

Lease Owner Nadel and Gussman
Lease Name GISH Well No. 7
Office Address 3232 First National Tower-Tulsa, OK 74103
Character of Well (Completed as Oil, Gas or Dry Hole): oil
Date Well Completed 5/9/57
Application for plugging filed 9/23/82
Plugging commenced 11/3/82
Plugging completed 11/3/82
Reason for abandonment of well or producing formation Depleted

Was permission obtained from the Conservation Division or it's
Agent's before plugging was commenced? yes

Name of Conservation Agent who supervised plugging of this well Gilbert Scheck

Producing formation Arbuckle Depth to top 3762 bottom 3766 T.D. 3766

Show depth and thickness of all water, oil and gas formations.

OIL, GAS OR WATER RECORDS Casing Record

Formation	Content	From	To	Size	Put in	Pulled Out
Arbuckle	oil	3762	3766	8-5/8"	176'	none
				5-1/2"	3763'	none

Describe in detail the manner in which the well was plugged, indicating where the mud fluid was placed and the method or methods used in introducing it into the hold. If cement or other plugs were used, state the character of same and depth placed, from _____ feet to _____ feet for each plug set.

Perforated at 625 ft. and 1650 ft.; plugged hole with 275 sacks cement; 200# psi

RECEIVED
STATE CORPORATION COMMISSION
11-10-82
NOV 10 1982
CONSERVATION DIVISION
Wichita Kansas

(If additional description is necessary, use BACK of this sheet)

Name of Plugging Contractor Allied Cementing Company (Russell, Ks.)

STATE OF OKLAHOMA COUNTY OF TULSA, ss.
M. R. Taylor, Mgr. of Production (employee of owner) or (owner or operator) of the above-described well, being first duly sworn on oath, says: That I have knowledge of the facts, statements, and matters herein contained and the log of the above-described well as filed and that the same are true and correct. So help me God.

(Signature) MRT Taylor
3232 First National Tower-Tulsa, OK 74103
(Address)

SUBSCRIBED AND SWORN TO before me this 8th day of November, 1982

Mildred Carter
Notary Public.

My Commission expires: 5/11/83

WELL LOG

15-163-01899-0000

NADEL AND GUSMAN

GISH WELL No. 7

NE SW SW 6-10-19
Rooks County, Kansas

Comm: 4-29-57
Comp: 5-9-57

Casing: 8-5/8" 176' w/125 sax
5-1/2" 3763' w/150 sax

Formations

Depths

Surface	176
Shale, sand, shells	1375
Shale, shells, red bed	1650
Anhydrite	1690
Shale and shells	2245
Shale and lime	2540
Shale and shells	2735
Lime and shale	2910
Shale	3050
Lime and shale	3320
Lime	3715
Lime and chert	3750
Lime	3762
Arbuckle	3766

Geological Tops

Topoka	3225'
Heebner Shale	3433'
Toronto Lime	3451-43'
Lansing-Kansas C.	3471'
Base Kansas City	3680'
Basal Penn. Cong.	3709'
Simpson Shale	3740-62'
Arbuckle Dolomite	3762'

STATE OF KANSAS }
COUNTY OF SEDGWICK }

E. G. McNeil, deposes and states that the above formations and depths are correct to his best knowledge and belief.

E. G. McNeil

Subscribed and sworn to before me this 13th day of May, 1957.

[Signature]

Notary Public

My commission expires 11-3-60