


WELL PLUGGING RECORD

Give All Information Completely
Make Required Affidavit
Mail or Deliver Report to:
Conservation Division
State Corporation Commission
800 Biting Building
Wichita, Kansas

Rooks County, Sec. 17 Twp. 10S Rge. 19W (W)

Location as "NE/CNW/SW" or footage from lines NW SW SW
Lease Owner Sunray Oil Corporation
Lease Name Berland Well No. 1
Office Address P. O. Box 195, Great Bend, Kansas
Character of Well (completed as Oil, Gas or Dry Hole) Dry Hole
Date well completed January 10 19 55
Application for plugging filed January 11 19 55
Application for plugging approved January 12 19 55
Plugging commenced February 21 19 55
Plugging completed February 27 19 55
Reason for abandonment of well or producing formation Dry Hole

NORTH

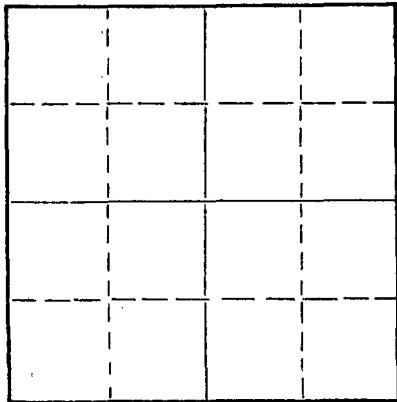

Locate well correctly on above
Section Plat

If a producing well is abandoned, date of last production 19
Was permission obtained from the Conservation Division or its agents before plugging was commenced? Yes

Name of Conservation Agent who supervised plugging of this well Eldon Petty
Producing formation Depth to top Bottom Total Depth of Well 3802 Feet
Show depth and thickness of all water, oil and gas formations.

OIL, GAS OR WATER RECORDS

CASING RECORD

FORMATION	CONTENT	FROM	TO	SIZE	PUT IN	PULLED OUT
Heebner		3402		8 5/8	208	none
Toronto		3425		5 1/2	3801	1981
Lsg Kansas City		3441				
Base Kansas City		3618				
Conglomerate		3695				
Simpson		3748				
Arbuckle		3761				
Total Depth		3802				

Describe in detail the manner in which the well was plugged, indicating where the mud fluid was placed and the method or methods used in introducing it into the hole. If cement or other plugs were used, state the character of same and depth placed, from feet to feet for each plug set.

Cement inside casing was drilled out to 3784' and casing was perforated from 3765' to 3771'. Filled hole with sand from 3784' to 3755' and ran 4 sacks of cement. Mudded the hole to 208', set a rock bridge to 195' and ran 15 sacks of cement. Mudded hole to 40', set a 10' rock bridge and ran 10 sacks of cement to top. Plugging completed.

Well log attached.

(If additional description is necessary, use BACK of this sheet)

Name of Plugging Contractor West Supply Company, Inc.
Address Chase, Kansas


STATE OF KANSAS, COUNTY OF BARTON
Norman E. Montgomery (employee of owner) or operator of the above-described well, being first duly sworn on oath, says: That I have knowledge of the facts, statements, and matters herein contained and the log of the above-described well as filed and that the same are true and correct. So help me God.

(Signature) Norman E. Montgomery
P. O. Box 195, Great Bend, Kansas
(Address)

SUBSCRIBED AND SWORN to before me this 16th day of March, 19 55

My commission expires December 24, 1956

Notary Public.

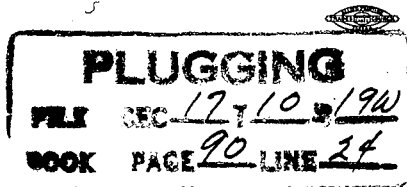

3-17-55

Sunray Oil Corporation
Tulsa, Oklahoma

Tulsa, Oklahoma
January 3, 1954

CONTRACTOR: Stickle Drilling Company
Drilling Commenced: December 18, 1954
Drilling Completed: January 2, 1954

P. Berland, P. M. A. of
Section 17-10S-19W, Rocks
County, Kansas.

DRILLERS LOG

Shale & Shells	0-785
Dakota Sand	785-810
Sand	810-950
Shale & Sand	950-1230
Shale & Red Bed	1230-1570
Red Bed	1570-1600
Anhydrite	1600-1650
Shale & Shells	1650-2130
Broken Lime & Shale	2130-2170
Lime	2170-2340
Lime & Shale	2340-2505
Lime	2505-2630
Lime & Shale	2630-2770
Lime	2770-3115
Lime & Shale	3115-3310
Lime	3310-3664
Shale	3664-3710
Conglomerate	3710-3753
Lime	3753-3769
Arbuckle	3769-3805 TD

I, Frank E. Stickle hereby certify the above to be a true and complete Drillers Log of Sunray Oil Corporation's P. Berland P. M. A. of Section 17-10S-19W, Rocks County, Kansas.

Frank E. Stickle
Frank E. Stickle

William J. Bonham
Notary Public

February 13, 1956
My Commission Expires

