


WELL PLUGGING RECORD

Give All Information Completely
Make Required Affidavit
Mail or Deliver Report to:
Conservation Division
State Corporation Commission
800 Bittling Building
Wichita, Kansas

NORTH

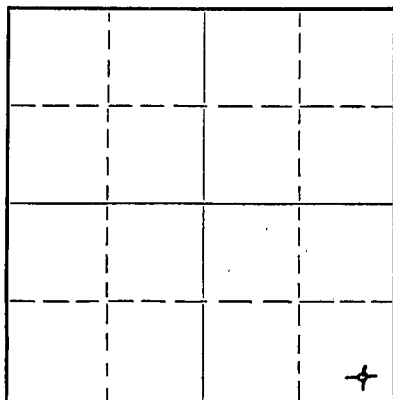

Locate well correctly on above
Section Plat

Rooks County. Sec. 17 Twp. 10S Rge. (E) 19 (W)
Location as "NE/CNW $\frac{1}{4}$ SW $\frac{1}{4}$ " or footage from lines SE SE SE
Lease Owner Peel-Hardman
Lease Name Berland Well No. 1
Office Address P. O. Box 359, Hoisington, Kansas
Character of Well (completed as Oil, Gas or Dry Hole) Dry Hole
Date well completed July 5 19 51
Application for plugging filed August 17 19 51
Application for plugging approved August 17 19 51
Plugging commenced August 17 19 51
Plugging completed August 24 19 51
Reason for abandonment of well or producing formation Dry Hole

If a producing well is abandoned, date of last production 19
Was permission obtained from the Conservation Division or its agents before plugging was commenced? Yes

Name of Conservation Agent who supervised plugging of this well Eldon Petty
Producing formation Depth to top Bottom Total Depth of Well 3739 Feet
Show depth and thickness of all water, oil and gas formations.

AUG 30 1951
8-30-51

OIL, GAS OR WATER RECORDS

CASING RECORD

Formation	Content	From	To	Size	Put In	Pulled Out
		0	225'	8 5/8"	225'	None
		0	3734'	5 1/2"	3734'	3173'

Describe in detail the manner in which the well was plugged, indicating where the mud fluid was placed and the method or methods used in introducing it into the hole. If cement or other plugs were used, state the character of same and depth placed, from feet to feet for each plug set.

3739' to 3726 $\frac{1}{2}$ ' - Heavy Rotary Mud
3726 $\frac{1}{2}$ ' to 3725' - Wooden Plug
3725' to 3693' - 4 sacks cement
3693' to 211 $\frac{1}{2}$ ' - Heavy Rotary Mud
211 $\frac{1}{2}$ ' to 210' - Rock Bridge
210' to 164' - 15 sacks cement
164' to 36 $\frac{1}{2}$ ' - Heavy Rotary Mud
36 $\frac{1}{2}$ ' to 35' - Rock Bridge
35' to 6' - 10 sacks cement
6' to Surface - Cellar

Name of Plugging Contractor Bert Self
Address 419 E. Sixth Street, Hutchinson, Kansas

STATE OF Kansas, COUNTY OF Barton, ss.
Peel-Hardman (employee of owner) or (owner or operator) of the above-described well,

being first duly sworn on oath, says: That I have knowledge of the facts, statements, and matters herein contained and the log of the above-described well as filed and that the same are true and correct. So help me God.

PEEL-HARDMAN
BY: [Signature]
(Signature) P. O. Box 359, Hoisington, Kansas
(Address)

SUBSCRIBED AND SWORN TO before me this 29th day of August, 1951
Manaw M. Herber Notary Public.

My commission expires June 4, 1951 23-8390-s 6-51-20M

PLUGGING
FILE SEC 17 T 10 R 1951
BOOK PAGE 106 LINE 5

DRILLER'S LOG

Company: Peel-Hardman

SE SE SE

Farm: Berland Well No. 1
Comm: 6-19-51 Comp: 7-5-51

Sec. 17, Twp. 10S, Rge. 19W,

County: Rooks,
Kansas

Total Depth: 3739'

Contractor: Peel-Hardman

Elevation:

Casing:

8 5/8" 225' cem.
5 1/2" 3734' cem.

Production: Dry

Figures below indicate bottom of formations

Sand	0 -	30
Sand & Shale		85
Shale		620
Sand		670
Shale		780
Sand		870
Shale		1085
Sand		1340
Shale		1425
Shale & Red Bed		1580
Anhydrite		1625
Shale		1885
Shale & Shells		2425
Lime & Shale		2765
Shale & Shells		3090
Shale & Lime		3385
Shale		3455
Lime & Shale		3535
Lime		3739
Total Depth		3739

Moved cable tools in July 2, 1951, drilled cement and cleaned out to bottom, ran Lane-Wells Radioactivity log, completed as a dry hole July 5, 1951.

This is to certify that the above information is to the best of my knowledge true and correct.

PEEL-HARDMAN

BY: Wm J Perfect

SUBSCRIBED AND SWORN to before me this 29th day of August, 1951.

My commission expires June 4, 1955Marion M. Herkel
Notary Public