

15-163-30164-0000

STATE OF KANSAS  
STATE CORPORATION COMMISSION


Form CP-4

Give All Information Completely  
Make Required Affidavit  
Mail or Deliver Report to:  
Conservation Division  
State Corporation Commission  
212 No. Market  
Wichita, Kansas

WELL PLUGGING RECORD

Rooks County, Sec. 17 Twp. 10S Rge. 19W(E) (W)  
Location as "NE/CNW/SW" or footage from lines NW NW NW  
Lease Owner Frontier Oil Company  
Lease Name Dick Well No. 3  
Office Address 1720 Wichita Plaza, Wichita, Kansas  
Character of Well (completed as Oil, Gas or Dry Hole) Dry Hole  
Date well completed June 21, 19 66  
Application for plugging filed June 21, 19 66  
Application for plugging approved June 21, 19 66  
Plugging commenced June 21, 19 66  
Plugging completed June 21, 19 66  
Reason for abandonment of well or producing formation D & A

NORTH

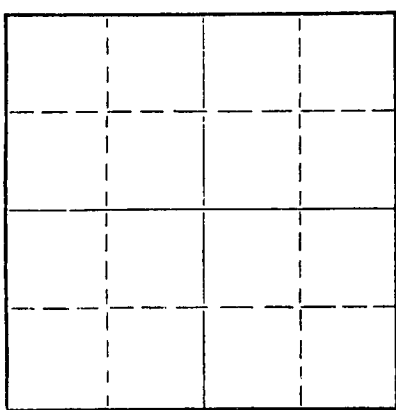

Locate well correctly on above  
Section Plat

If a producing well is abandoned, date of last production 19  
Was permission obtained from the Conservation Division or its agents before plugging was commenced? Yes

Name of Conservation Agent who supervised plugging of this well Leo F. Massey  
Producing formation Depth to top Bottom Total Depth of Well 3778 Feet  
Show depth and thickness of all water, oil and gas formations.

OIL, GAS OR WATER RECORDS

CASING RECORD

FORMATION	CONTENT	FROM	TO	SIZE	PUT IN	PULLED OUT
				8 5/8"	216'	None

Describe in detail the manner in which the well was plugged, indicating where the mud fluid was placed and the method or methods used in introducing it into the hole. If cement or other plugs were used, state the character of same and depth placed, from feet to feet for each plug set.

Set plug at 540' with 20 sacks of cement.  
Set plug at 195' with 20 sacks of cement.  
Set plug at 40' with 1/2 sack of hulls and 10 sacks of cement.

6-30-66  
JUN 30 1966  
CONSERVATION DIVISION  
WICHITA, KANSAS

(If additional description is necessary, use BACK of this sheet)

Name of Plugging Contractor Red Tiger Drilling Company  
Address Box 173 -- Russell, Kansas


STATE OF KANSAS, COUNTY OF SEDGWICK, ss.  
Maxine V. Starr (employee of owner) or (owner or operator) of the above-described

well, being first duly sworn on oath, says: That I have knowledge of the facts, statements, and matters herein contained and the log of the above-described well as filed and that the same are true and correct. So help me God.

(Signature) Maxine V. Starr  
1720 Wichita Plaza, Wichita, Kansas  
(Address)

SUBSCRIBED AND SWORN to before me this 29th day of June, 19 66

Notary Public

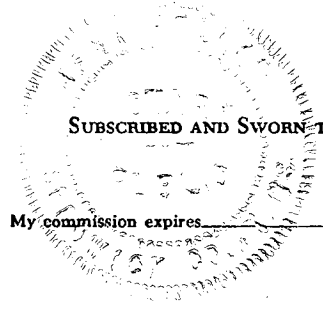

My commission expires 5-22-70

DRILLERS LOG

Dick No. 3

CASING RECORD:	COMPANY:	Frontier Oil Company	DESCRIPTION:
8 5/8" @ 216'	CONTRACTOR:	Red Tiger Drilling Company	NW NW NW
w/140 sx cement	COMMENCED:	June 14, 1966	17-10S-19W
	COMPLETED:	June 21, 1966	Rooks Co., Ks.
			ELEVATION: 2193 DF
			2196 RB
TOTAL DEPTH:	3778'		

<u>FORMATION</u>	<u>FROM</u>	<u>TO</u>	<u>REMARKS</u>
Surface	0	225	
Shale	225	800	
Shale & Sand	800	1040	
Sand	1040	1285	
Shale	1285	1610	
Anhydrite	1610	1648	
Shale	1648	2130	
Shale & Lime	2130	3370	
Lime	3370	3778	

RECEIVED  
 STATE OF KANSAS COMMISSION  
 JUN 20 1966  
 CONSERVATION DIVISION  
 Wichita, Kansas

I certify that this is a true and correct copy of the above log to the best of my knowledge.

FRONTIER OIL COMPANY

Maxine V. Starr  
 Maxine V. Starr

Subscribed and sworn to before me this 29th day of June, 1966.

Jean Stellan  
 Notary Public

My Commission Expires:  
5-22-70

