


STATE OF KANSAS  
STATE CORPORATION COMMISSION

Give All Information Completely  
Make Required Affidavit  
Mail or Deliver Report to:  
Conservation Division  
State Corporation Commission  
800 Bitting Building  
Wichita, Kansas

WELL PLUGGING RECORD

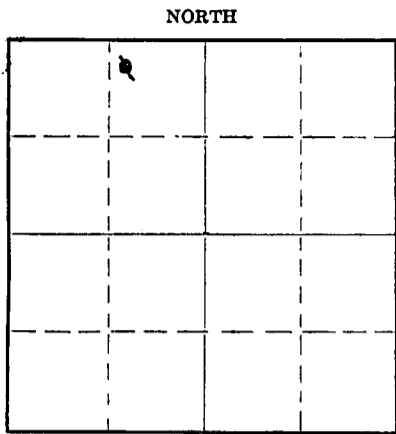

Locate well correctly on above  
Section Plat

Rooks County. Sec. 18 Twp. 10 Rge. 19 (EXXX) (W)  
Location as "NE/CNW 1/4 SW 1/4" or footage from lines \*See below.  
Lease Owner Birmingham-Bartlett Drilling Co.  
Lease Name Marcotte Well No. 2A  
Office Address 705 Petroleum Bldg., Wichita, Kansas  
Character of Well (completed as Oil, Gas or Dry Hole) dry hole  
Date well completed September 17, 1949  
Application for plugging filed September 17, 1949  
Application for plugging approved September 17, 1949  
Plugging commenced September 17, 1949  
Plugging completed September 17, 1949  
Reason for abandonment of well or producing formation

If a producing well is abandoned, date of last production 19  
Was permission obtained from the Conservation Division or its agents before plugging was commenced? yes

Name of Conservation Agent who supervised plugging of this well Eldon Petty, Box 326, Hays, Kansas  
Producing formation Depth to top Bottom Total Depth of Well 3868 Feet  
Show depth and thickness of all water, oil and gas formations.

OIL, GAS OR WATER RECORDS

CASING RECORD

Formation	Content	From	To	Size	Put In	Pulled Out
	Surface Casing:	Ran 7 jts.	209.89'	of 8-3/8" casing	cemented	
		at 204'	with 150 sacks	cement.		
* Location: 370' South and 340' West of NE Corner of West 104-1/5 A. of the NW 1/4						

Describe in detail the manner in which the well was plugged, indicating where the mud fluid was placed and the method or methods used in introducing it into the hole. If cement or other plugs were used, state the character of same and depth placed, from feet to feet for each plug set.

Plugged well with 150 sacks cement on bottom, plug at bottom of surface, 200', and 10 sacks on top; plug 30' below bottom of cellar.

9-22-49  
SEP 22 1949

(If additional description is necessary, use BACK of this sheet)


Correspondence regarding this well should be addressed to Birmingham-Bartlett Drilling Co.  
Address 705 Petroleum Bldg., Wichita, Kansas

STATE OF KANSAS, COUNTY OF SEDGWICK, ss.  
Richard Hindery partner (employee of owner or operator) of the above-described well,  
being first duly sworn on oath, says: That I have knowledge of the facts, statements, and matters herein contained and the log of the above-described well as filed and that the same are true and correct. So help me God.  
(Signature) Richard Hindery  
705 Petroleum Bldg. Wichita, Kansas  
(Address)

SUBSCRIBED AND SWORN to before me this 20th day of September, 1949

Vivian F. Ginger  
Notary Public.

My commission expires November 29, 1950.

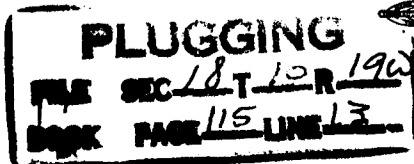

15-163-19422-0000

MARCOTTE #2A WELL

LOCATION NE Cor. of W. 104-1/5 A. of NW 1/4  
 Sec. 18-10-19W, Rooks County, Kansas

OPERATOR: Birmingham-Bartlett Drilling Co.

CONTRACTOR: Birmingham-Bartlett Drilling Co.

SURFACE CASING: Ran 7 jts., 209.89' of 8-5/8" casing  
 cemented at 204' with 150 sacks cement.

OIL STRING: None. D & A

SPUDDED: 9-1-49

COMPLETED: 9-17-49

L O O

(Figures indicate bottom of formation)

0	to	204	Clay and shale	
		755	Shale	
		815	Sand and shale	
		900	Sand	
		1080	Shale and shells	
		1300	Sand	
		1420	Shale and red bed	
		1640	Shale	
		1670	Anhydrite	
		1840	Shale and shells	
		2105	Shale	
		2190	Shale and shells	
		2655	Lime and shale	
		2805	Shale	
		2895	Shale and shells	
		3020	Shale	
		3095	Shale, lime and shells	
		3175	Shale	
		3415	Lime and shale	
		3583	Lime	
		3625	Lime and shale	
		3755	Lime	
		3794	Chert	
		3850	Conglomerate	
		3868	Arbuckle	
				Total Depth: 3868

The undersigned RICHARD HINDERY of the BIRMINGHAM-BARTLETT DRILLING CO. hereby certifies that the above is a true and correct log of the formations encountered in drilling the above noted well as shown on the daily drilling tickets.

BIRMINGHAM-BARTLETT DRILLING CO.

Richard Hindery

Sworn to and subscribed before me  
 this 20th day of September, 1949.

William J. Genger  
 Notary Public

My commission expires November 29, 1950.

**PLUGGING**  
 FILE SEC 18 T 10 R 196  
 BOOK PAGE 115 LINE 13