

STATE OF KANSAS
STATE CORPORATION COMMISSION

Give All Information Completely
Make Required Affidavit
Mail or Deliver Report to:
Conservation Division
State Corporation Commission
211 No. Broadway
Wichita, Kansas

WELL PLUGGING RECORD

Rooks County, Sec. 18 Twp. 10s Rge. 19 (E) (W)

Location as "NE/CNW/SW" or footage from lines NE NE SE

Lease Owner PETROLEUM, INC.,

Lease Name SCOGGINS Well No. 1

Office Address R.R. #2, GREAT BEND, KANSAS

Character of Well (completed as Oil, Gas or Dry Hole) DRY HOLE

Date well completed 5-29- 19 64

Application for plugging filed 5-29- 19 64

Application for plugging approved 5-29- 19 64


Plugging commenced 5-29- 19 64

Plugging completed 5-29- 19 64

Reason for abandonment of well or producing formation NO PRODUCIBLE FORMATIONS

If a producing well is abandoned, date of last production - 19 -

Was permission obtained from the Conservation Division or its agents before plugging was commenced? YES

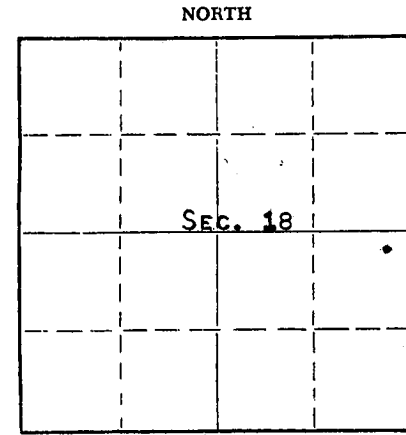

Locate well correctly on above Section Plat

Name of Conservation Agent who supervised plugging of this well ELDON PETTY

Producing formation - Depth to top - Bottom - Total Depth of Well 3800' Feet

Show depth and thickness of all water, oil and gas formations.

OIL, GAS OR WATER RECORDS

CASING RECORD

FORMATION	CONTENT	FROM	TO	SIZE	PUT IN	PULLED OUT
				8-5/8	256'	NONE

Describe in detail the manner in which the well was plugged, indicating where the mud fluid was placed and the method or methods used in introducing it into the hole. If cement or other plugs were used, state the character of same and depth placed, from feet to feet for each plug set.

MUDDED UP WITH HEAVY MUD TO 540', FOLLOWED BY A WOODEN PLUG AND 20 SACKS CEMENT. MUDDED UP WITH HEAVY MUD TO 240', FOLLOWED BY A WOODEN PLUG AND 20 SACKS CEMENT. MUDDED UP WITH HEAVY MUD TO 40', FOLLOWED BY A WOODEN PLUG AND 10 SACKS CEMENT TO BASE OF WELL CELLAR.

RECEIVED
STATE CORPORATION COMMISSION
6-11-64
JUN 11 1964

CONSERVATION DIVISION
Wichita, Kansas

(If additional description is necessary, use BACK of this sheet)

Name of Plugging Contractor GARVEY DRLG. Co.
Address R.R. #2, GREAT BEND, KANSAS

STATE OF KANSAS, COUNTY OF BARTON, ss.
MONTE CHADD (employee of owner) or (owner/contractor) of the above-described

well, being first duly sworn on oath, says: That I have knowledge of the facts, statements, and matters herein contained and the log of the above-described well as filed and that the same are true and correct. So help me God. MONTE CHADD, DIST. PROD. SUPT.

(Signature)

R.R. #2, GREAT BEND, KANSAS (Address)

SUBSCRIBED AND SWORN to before me this 10TH day of JUNE, 19 64

My commission expires SEPTEMBER 23, 1967

Notary Public.

WELL LOG

15-163-02619-0000

COMPANY Petroleum, Inc

SEC. 18 T. 10S R. 19W

FARM Scoggins NO. 1


LOC: NE NE SE

TOTAL DEPTH 3800'

COUNTY Rooks

COMM. 5-19-64 COMP. 5-29-64

CONTRACTOR Garvey Drilling Company

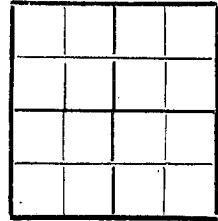

CASING 8 5/8" @ 256' w/150 sx

ELEVATION 2214 K.B.

PRODUCTION D & A

FIGURES INDICATE BOTTOM OF FORMATIONS

- 100' Surface Soil and Sand
- 256' Blue Shale
- 830' Shale
- 1325' Sand and Shale
- 1649' Shale and Red Bed
- 1682' Anhydrite
- 2175' Shale
- 2377' Shale and Lime
- 3250' Lime and Shale
- 3655' Lime
- 3735' Shale and Lime
- 3800' Conglomerate
- 3800' RTD

RECEIVED
STATE CORPORATION COMMISSION

JUN 11 1964

CONSERVATION DIVISION
Wichita, Kansas

State of Kansas }
County of Barton } ss

I, Sam N. Stephens of Garvey Drilling Company

upon oath state the above and foregoing is a true and correct copy of the log of the Scoggins #1 well.

Sam N. Stephens

Subscribed and sworn to before me this 5th day of June 19 64

My Commission Expires: September 23rd, 1967

Howard A. Reiser
NOTARY PUBLIC