

DISTRICT CONSERVATION AGENT'S REPORT

TO:

State Corporation Commission
 Conservation Division
 800 Bitting Building
 Wichita, Kansas

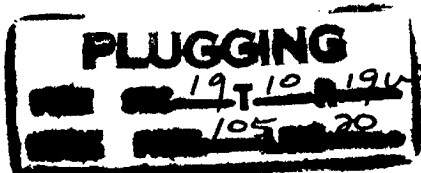
FILE NO. _____

LOCATION NW-NWSESEC. 19 TWP. 10 RGE. 19Dry Hole X Abandoned Oil Well _____ Abandoned Gas Well _____

I have today completed supervision of plugging of:

Well No. 1 Lease BerlandOperator Petroleum Inc Address Wichita, KansField Berland County RooksTotal Depth 3811 Feet.

(Describe briefly the manner in which the well was plugged)

8 5/8" at 198' circulated with cement - 5 1/2" at 3808'Lane Wells plugs to 3528', top perforations at 3510' -Chat from 3528' to 3500 and 5 sax cement - Heavy mud to 200',wood plug, rock and 15 sax cement - Heavy mud to 35', wood plug,rock and 10 sax cement

 District Conservation Agent
Date 7-13-49

Conservation Div.

 7-14-49
 JUL 14 1949

 RECEIVED
 STATE CORPORATION
 COMMISSION
 KANSAS