


STATE OF KANSAS
STATE CORPORATION COMMISSION

WELL PLUGGING RECORD

Give All Information Completely
Make Required Affidavit
Mail or Deliver Report to
Conservation Division
State Corporation Comm.
245 North Water
Wichita, KS 67202

ROOKS County. Sec. 19 Twp. 10S Rge. 19 $\frac{1}{4}$ / $\frac{1}{4}$ / $\frac{1}{4}$
Location as "NE/CNW $\frac{1}{4}$ /SW $\frac{1}{4}$ " or footage from lines NW/SW/NW
WORDEN PETROLEUM CO.

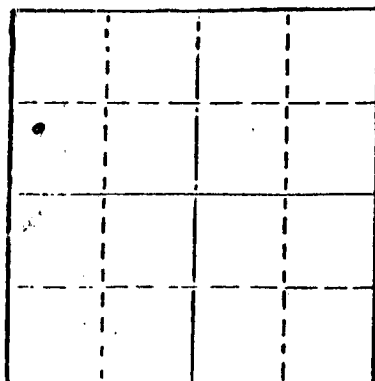

Locate well correctly on above
Section Plot

Lease Owner
Lease Name HENRY BERLAND Well No. "A" 16
Office Address P.O. Box No. 996 Hays, Kansas 67601
Character of Well (Completed as Oil, Gas or Dry Hole)
Originally drilled by TEXACO
Date Well completed About 12/9/1952 19
Application for plugging filed Worden 9/17/79&5/6/ 1980
Application for plugging approved 9/19/1980 19
Plugging commenced 9/24/ 1980
Plugging completed 5:30 P.M. 9/24/ 1980
Reason for abandonment of well or producing formation
Was forced to quit and vacate lease without testing, by Henry Berland.
If a producing well is abandoned, date of last production 19

Was permission obtained from the Conservation Division or
its agents before plugging was commenced? Yes

Name of Conservation Agent who supervised plugging of this well Mr. Marion Schmidt
Producing formation Depth to top Bottom Total Depth of Well 3778'
Show depth and thickness of all water, oil and gas formations.

NOTE: Worden Pet. DID NOT re-open this well but was forced to surrender lease rights
OIL, GAS OR WATER RECORDS

CASING RECORD

FORMATION	CONTENT	FROM	TO	SIZE	PUT IN	PULLED OUT
				10 3/4"	295'	None
				7"	3778'	None

Describe in detail the manner in which the well was plugged, indicating where the mud fluid
was placed and the method or methods used in introducing it into the hold. If cement or other
plugs were used, state the character of same and depth placed, from _____ feet to
_____ feet for each plug set. Put 1-1/2 Barrels sand on bottom, at 3778',
capped with 1/2 YD., of Readi-Mix concrete.

Built a 45' rock & gravel bridge at 1000', then put in 6-1/2 YDS., concrete.

When well was checked 9/25/80, found concrete had settled.

Worden ordered another yard of concrete, (readi-Mix) from Hays and completely
filled the 7" casing in this well 9/26/ 1980.

Ready-Mix was furnished by: Allied Inc., 503 E. 10th., Hays, Kansas 67601

(If additional description is necessary, use BACK of this sheet)

Name of Plugging Contractor WORDEN PETROLEUM CO.

STATE OF KANSAS COUNTY OF ELLIS, ss.
G. W. BENNETT (employee of owner) or (owner or operator)
of the above-described well, being first duly sworn on oath, says: That I have knowledge of
the facts, statements, and matters herein contained and the log of the above-described well
as filed and that the same are true and correct. So help me God.

(Signature)

[Signature]
WORDEN PETROLEUM CO.


(Address)

29th day of SEPTEMBER, 1980

[Signature]
Notary Public.

My commission expires

Nov 22, 1980

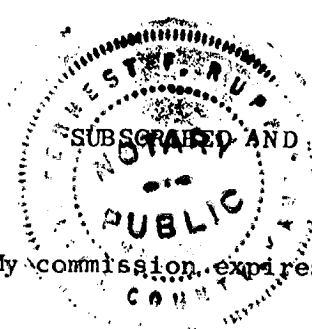

RECEIVED
STATE CORPORATION COMMISSION
7-30-80
SEP 30 1980
CONSERVATION DIVISION
Wichita, Kansas

IN THE DISTRICT COURT OF ROOKS COUNTY, KANSAS

HENRY BERLAND	Plaintiff)	
)	
-vs-)	No. 79-C-14
)	
G. W. BENNETT, SR., et al	Defendants)	

ORDER

Now on this 2nd day of September, 1980, the same being the first day of the September 1980 term of Court, and Court being in due and legal session, the motion of plaintiff, Henry Berland, for citation order comes regular on for hearing pursuant to order of continuance entered on May 5, 1980. Plaintiff appearing by his attorney, Stanley Krysl of the firm of Hindman & Krysl of Stockton, Kansas, and defendant G. W. Bennett, Sr. appears in person without counsel.

THEREUPON said motion was fully presented to the Court and the Court, after due consideration, FINDS that said motion should be granted.

IT IS THEREFORE BY THE COURT CONSIDERED and ORDERED that G. W. Bennett, Sr. cause the No. 15 and No. 16 wells on the Berland lease to be plugged as provided by law, such plugging to be completed on or before October 1, 1980.

Kevin R. Weeoughly
 DISTRICT JUDGE

O. K. HINDMAN & KRYSL
 By: *Stanley Krysl*
 Stanley Krysl
 Attorney for Plaintiff

RECEIVED
 STATE CORPORATION COMMISSION
 SEP 30 1980
 CONSERVATION DIVISION
 Wichita, Kansas